

CARD MUST BE TYPED

State of Kansas
NOTICE OF INTENTION TO DRILL
(see rules on reverse side)

Extended to 1-2-86
EARLYWINE PROSPECT
6-28-85 CARD MUST BE SIGNED

Starting Date: 1-15-85
month day year

API Number 15- 151-21,554-00-00

OPERATOR: License # 5087

C NW NW Sec 2 Twp 27 S, Rge 15
(location) East West

Name Texas Energies, Inc.

Address P.O. Box 947

City/State/Zip Pratt, Kansas 67124

Contact Person Brian G. Fisher

Phone 316-838-5599

CONTRACTOR: License # 5149

Name Wheatstate Oilfield Ser.

City/State Pratt, Kansas 67124

4620 Ft North from Southeast Corner of Section
4620 Ft West from Southeast Corner of Section
(Note: Locate well on Section Plat on reverse side)

Nearest lease or unit boundary line 660 feet.

County Pratt

Lease Name Earlywine Well# 1-2

Domestic well within 330 feet: yes no

Municipal well within one mile: yes no

Well Drilled For: Well Class: Type Equipment:

- Oil Swd Infield Mud Rotary
- Gas Inj Pool Ext. Air Rotary
- OWWO Expl Wildcat Cable

Depth to Bottom of fresh water 300 feet

Lowest usable water formation 100

Depth to Bottom of usable water 300 feet

Surface pipe by Alternate: 1 2

Surface pipe to be set 450 feet

Conductor pipe if any required None feet

Ground surface elevation feet MSL

* This Authorization Expires ~~7-2-85~~ 1-2-86

Approved By *RGH/KCC* 1-2-85

If OWWO: old well info as follows:

Operator

Well Name

Comp Date Old Total Depth

Projected Total Depth 4600 feet

Projected Formation at TD Viola

Expected Producing Formations Kinderhook Shale

I certify that we will comply with K.S.A. 55-101, et seq., plus eventually plugging hole to K.C.C. specifications.

Date 12-28-84 Signature of Operator or Agent

Brian G. Fisher

Title Exploration Manager

MHC/KDHE 1/2/85

Must be filed with the K.C.C. five (5) days prior to commencing well
 This card void if drilling not started within six (6) months of date received by K.C.C.


Wichita, Kansas
 CONSERVATION DIVISION

DEC 28 1984
 48-28-21

RECEIVED
 STATE OF KANSAS
 CONSERVATION DIVISION
 A Regular Section of Land

Important procedures to follow:

1. Notify District office before setting surface casing.
2. Set surface casing by circulating cement to the top.
3. File completion forms ACO-1 with K.C.C. within 90 days of well completion, following instructions on ACO-1, side 1, and including copies of wireline logs.
4. Notify District office 48 hours prior to old well workover or re-entry.
5. Prior to plugging, prepare a plugging plan, then obtain agreement from the appropriate district office for an approved plugging plan.
6. Submit plugging report (CP-4) to K.C.C. after plugging is completed.
7. Obtain an approved injection docket number before disposing of salt water.
8. Notify K.C.C. within 10 days when injection commences or terminates.
9. If an alternate 2 completion, cement in the production pipe from below any usable water to surface within 120 days of spud date.

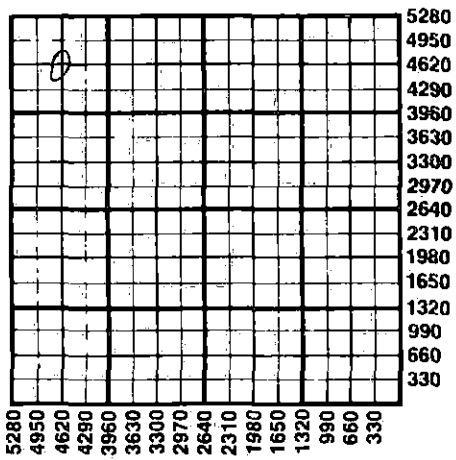

**State Corporation Commission of Kansas
 Conservation Division
 200 Colorado Derby Building
 Wichita, Kansas 67202
 (316) 263-3238**