

* 440' South of NL
1320' East of WL


STATE OF KANSAS
STATE CORPORATION COMMISSION

Form CP-4

WELL PLUGGING RECORD

Give All Information Completely
Make Required Affidavit
Mail or Deliver Report to:
Conservation Division
State Corporation Commission
212 No. Market
Wichita, Kansas

NORTH

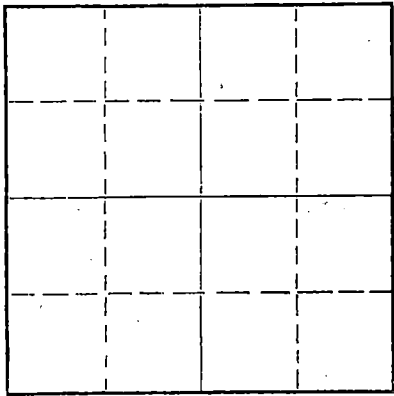

Locate well correctly on above Section Plat

Pratt County, Sec. 13 Twp. 27 Rge. (E) 15(W)

Location as "NE/CNWxSWx" or footage from lines * SE/4

Lease Owner United States Hydrocarbon Company

Lease Name Jones-Maas Well No. 2

Office Address P. O. Box 11027 Washington St. Station, Wichita, Kans.

Character of Well (completed as Oil, Gas or Dry Hole) Dry Hole

Date well completed August 24 19 67

Application for plugging filed August 24 19 67

Application for plugging approved August 24 19 67

Plugging commenced August 24 19 67

Plugging completed August 24 19 67

Reason for abandonment of well or producing formation Dry Hole

If a producing well is abandoned, date of last production 19

Was permission obtained from the Conservation Division or its agents before plugging was commenced? Yes

Name of Conservation Agent who supervised plugging of this well Archie Elving, Pratt, Kansas

Producing formation Depth to top Bottom Total Depth of Well 4630 Feet

Show depth and thickness of all water, oil and gas formations.

OIL, GAS OR WATER RECORDS

CASING RECORD

Table with 7 columns: FORMATION, CONTENT, FROM, TO, SIZE, PUT IN, PULLED OUT. Row 1: 10-3/4", 0, 360.

Describe in detail the manner in which the well was plugged, indicating where the mud fluid was placed and the method or methods used in introducing it into the hole. If cement or other plugs were used, state the character of same and depth placed, from feet to feet for each plug set.

Plugged as follows: Plugged at 300' with 30 sacks of cement and 1/2 sack of hulls and mud to 40'; plugged at 40' with 15 sacks of cement. Also ran 2 sacks of cement in rat hole and 2 sacks of cement in mouse hole. Plug down at 6:00 P. M. August 24, 1967.

RECEIVED
STATE CORPORATION COMMISSION
SEP 18 1967
CONSERVATION DIVISION
Wichita, Kansas
09-18-67

(If additional description is necessary, use BACK of this sheet)

Name of Plugging Contractor Strata Drilling, Inc.

Address P. O. Box 355, Great Bend, Kansas 67530

STATE OF KANSAS, COUNTY OF BARTON, ss. Jim B. McWilliams (employee of owner) or (owner or operator) of the above-described well, being first duly sworn on oath, says: That I have knowledge of the facts, statements, and matters herein contained and the log of the above-described well as filed and that the same are true and correct. So help me God.

(Signature) Jim B. McWilliams, Secy-Treas. P. O. Box 355, Great Bend, Kansas 67530 (Address)

SUBSCRIBED AND SWORN TO before me this 28th day of August, 19 67

My commission expires December 14, 1969

Elaine H. Taylor Notary Public.

D R I L L E R S L O G

#2 Jones-Maas

CASING RECORD: 360' of new 10-3/4" surface casing.	COMPANY: United States Hydrocarbon Company	DESCRIPTION: SE/4 440' South of North Line 1320' East of West Line Section 13-27S-15W Pratt County, Kansas
TOTAL DEPTH: 4630'	CONTRACTOR: Strata Drilling, Inc.	
	COMMENCED: August 11, 1967	
	COMPLETED: August 24, 1967	ELEVATION: 2040' RB

D. & A.

<u>FORMATION</u>	<u>FROM</u>	<u>TO</u>	<u>REMARKS</u>
Sand & Shale	0	363	Ran 360' of new 10-3/4" surface casing; set and cemented at 360' with 150 sacks of regular cement, 4% gel and 150 sacks of regular cement, 2% gel. Plug down at 2:30 A. M. August 13, 1967.
Shale	363	480	
Shale & Shells	480	2035	
Lime & Shale	2035	3168	
Shale	3168	3287	
Shale & Lime	3287	4065	
Lime	4065	4475	
Cherty Lime	4475	4540	
Lime	4540	4630	

Total Depth 4630'

RECEIVED
STATE OF KANSAS

SEP 18 1967

CONSERVATION DIVISION
Wichita, Kansas

D. & A.

Hole plugged as follows: plugged at 300' with 30 sacks of cement and 1/2 sack of hulls and mud to 40'; plugged at 40' with 15 sacks of cement. Also ran 2 sacks of cement in rat hole and 2 sacks of cement in mouse hole. Plug down at 6:00 P. M. August 24, 1967.

STATE OF KANSAS)
) ss.
COUNTY OF BARTON)

I certify that this is a true and correct copy of the above log to the best of my knowledge.

STRATA DRILLING, INC.

Jim B. McWilliams
Jim B. McWilliams, Secy-Treas.

Subscribed and sworn to before me this 28th day of August, 1967.

Elaine H. Taylor
Elaine H. Taylor, Notary Public

Commission Expires:

September 14, 1969