


STATE OF KANSAS
STATE CORPORATION COMMISSION

Give All Information Completely
Make Required Affidavit
Mail or Deliver Report to:
Conservation Division
State Corporation Commission
800 Biting Building
Wichita, Kansas

WELL PLUGGING RECORD

NORTH

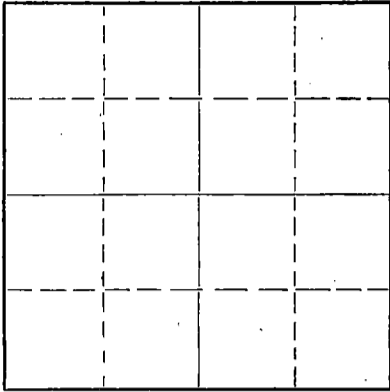

Locate well correctly on above
Section Plat

Pratt County, Sec. 12 Twp. 28S Rge. (E) 11(W)

Location as "NE/CNW/SW" or footage from lines NE NW NE

Lease Owner Beardmore Drilling Company

Lease Name Kemp Well No. 1-B

Office Address 603 Petroleum Bldg., Wichita 2, Kansas

Character of Well (completed as Oil, Gas or Dry Hole) Dry Hole

Date well completed September 20 19 52

Application for plugging filed September 20 19 52

Application for plugging approved September 20 19 52

Plugging commenced September 20 19 52

Plugging completed September 20 19 52

Reason for abandonment of well or producing formation Dry Hole

If a producing well is abandoned, date of last production 19

Was permission obtained from the Conservation Division or its agents before plugging was commenced? yes

Name of Conservation Agent who supervised plugging of this well C. D. Stough

Producing formation Mississippi Depth to top 4075 Bottom 4099 Total Depth of Well 4099 Feet

Show depth and thickness of all water, oil and gas formations.

OIL, GAS OR WATER RECORDS

CASING RECORD

FORMATION	CONTENT	FROM	TO	SIZE	PUT IN	PULLED OUT
Clay & Water Sand		-0-	120			
Shale - Shells		120	300	8-5/8"	297	-0-

Describe in detail the manner in which the well was plugged, indicating where the mud fluid was placed and the method or methods used in introducing it into the hole. If cement or other plugs were used, state the character of same and depth placed, from top feet to bottom feet for each plug set.

Heavy Mud from T. D. 4099 to 270'
Wood Plug at 270'
20 Sacks Cement at 270'
Mud from 220' to 35'
Wood Plug at 35'
10 Sacks Cement at 35'

RECEIVED
STATE CORPORATION COMMISSION
SEP 26 1952
CONSERVATION DIVISION
Wichita, Kansas

09-26-52

Name of Plugging Contractor Beardmore Drilling Company
Address 603 Petroleum Bldg., Wichita 2, Kansas

STATE OF KANSAS, COUNTY OF SEDGWICK, ss.
I, Heber Beardmore (employee of owner) or (owner or operator) of the above-described well, being first duly sworn on oath, says: That I have knowledge of the facts, statements, and matters herein contained and the log of the above-described well as filed and that the same are true and correct. So help me God.

(Signature) Heber Beardmore
603 Petroleum Bldg., Wichita 2, Kansas
(Address)

SUBSCRIBED AND SWORN TO before me this 23rd day of September 19 52

Leonard P. Tolle
Notary Public.

My commission expires January 28, 1956

PLUGGING
FILE SEC 12 T 28 R 1134
BOOK PAGE 46 LINE 15

Kemp No. 1-B

NE NW NE
Section 12-28S-11W
Pratt County, Kansas

Drilled for: Beardmore, Skelly & Bovaird
Drilled by: Beardmore Drilling Company

Casing Record:

8-5/8" 297' w/165 Sacks

Drilling Commenced: September 6, 1952
Drilling Completed: September 20, 1952

Elevation: GR 1745
DF 1748

<u>FORMATION</u>	<u>DEPTH</u>
Cellar	5
Sand	140
Red Rock - Shale - Shells	235
Shale - Shells	1100
Shale - Salt	1300
Lime - Shale	1525
Lime Broken	1870
Lime - Shale	2025
Lime Broken - Shale	2140
Shale - Lime	3035
Lime - Shale	3085
Sand	3100
Lime - Shale	3375
Lime	3895
Lime - Shale	4020
Lime	4099 T. D.

D & A

Tops:

Brown Lime	3564
Lansing	3585
Mississippi	4075

DST #1 - 4078-4099 - Fair Blow for 1/2 Hour, weak blow at end of 1 hour and 15 minutes. Shut in 15 minutes. Recovered 150' muddy water, 120' salt water, BHP 850#, Flow pressure zero.

STATE OF KANSAS

SS

COUNTY OF SEDGWICK


I, the undersigned, being duly sworn on oath state that the above and within statement is a true and correct record and log of the well drilled on the location above-described, to the best of my knowledge and belief.

John Beardmore

Subscribed and sworn to before me this 23rd day of September, 1952.

Leonard P. Tolle
Notary Public

My commission expires: January 28, 1956

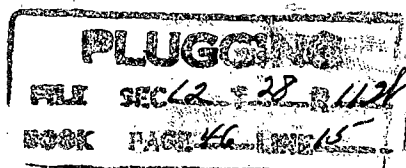

RECEIVED
STATE CORPORATION COMMISSION

SEP 26 1952

CONSERVATION DIVISION
Wichita, Kansas