

CARD MUST BE TYPED

EL. 12861

State of Kansas

CARD MUST BE SIGNED

NOTICE OF INTENTION TO DRILL

(see rules on reverse side)

Starting Date 2 month 15 day 87 year

API Number 15- 151-21,821-00-00

OPERATOR: License # 7210

NE SE NE Sec. 13 Twp. 27 S, Rg. 15W ~~East~~ West

Name B. Bently Corporation

Address P.O. Box 120

City/State/Zip Iuka, Kansas 67066

Contact Person Ben Beier/Randall Manwhirter

Phone 316-672-5184 / 316-549-6471

3910 Ft. from South Line of Section

295 Ft. from East Line of Section

(Note: Locate well on Section Plat on reverse side)

Nearest lease or unit boundary line 295 feet

County Pratt

Lease Name Jones "C" Well # 5 Twin

Ground surface elevation 2043 feet MSL

Domestic well within 330 feet: yes no

Municipal well within one mile: yes no

Depth to bottom of fresh water 300-250

Depth to bottom of usable water 300

Surface pipe by Alternate: 1 2

Surface pipe planned to be set 300

Conductor pipe required none

Projected Total Depth 4600 feet

Formation Simpson

CONTRACTOR: License # 5302

Name Red Tiger Drilling Co.

City/State Wichita, Kansas 67202

Well Drilled For: Well Class: Type Equipment:

Oil SWD Infield Mud Rotary

Gas Inj Pool Ext. Air Rotary

OWWO Expl Wildcat Cable

If OWWO: old well info as follows:

Operator

Well Name

Comp Date Old Total Depth

I certify that well will comply with K.S.A. 55-101, et seq., plus eventually plugging hole to KCC specifications.

Date 12-19-86 Signature of Operator or Agent Ben Beier Title Owner/Operator

For KCC Use: Ben Beier

Conductor Pipe Required feet; Minimum Surface Pipe Required 300 feet per Alt. 1

This Authorization Expires 6-22-87 Approved By 12-22-86


Per/KC

Must be filed with the K.C.C. five (5) days prior to commencing well
This card void if drilling not started within six (6) months of date received by K.C.C.

Important procedures to follow:

1. Notify District office before setting surface casing.
2. Set surface casing by circulating cement to the top.
3. File completion forms ACO-1 with K.C.C. within 90 days of well completion, following instructions on ACO-1, side 1, and including copies of wireline logs.
4. Notify District office 48 hours prior to old well workover or re-entry.
5. Prior to filing Intent, prepare a proposed plugging plan in case well is D & A, then obtain approval of plan when calling district office prior to setting surface pipe.
6. Submit plugging report (CP-4) to K.C.C. after plugging is completed.
7. Obtain an approved injection docket number before disposing of salt water.
8. Notify K.C.C. within 10 days when injection commences or terminates.
9. If an alternate 2 completion, cement in the production pipe from below any usable water to surface within 120 days of spud date.

A Regular Section of Land 1 Mile = 5,280 Ft.

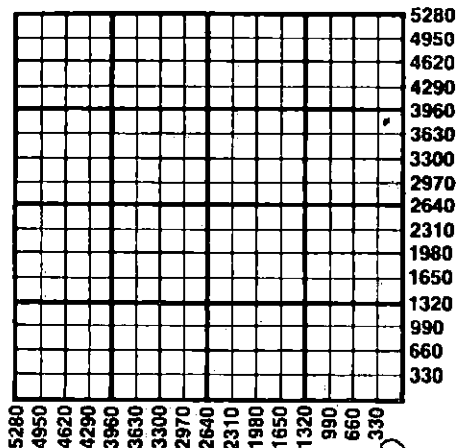

State Corporation Commission of Kansas
Conservation Division
200 Colorado Derby Building
Wichita, Kansas 67202
(316) 263-3238