

WELL PLUGGING RECORD


Give All Information Completely
Make Required Affidavit
Mail or Deliver Report to:
Conservation Division
State Corporation Commission
800 Bittling Building
Wichita, Kansas

Pratt

County. Sec. 7 Twp. 28 Rge. 11 (E) W (W)

Location as "NE/CNW $\frac{1}{4}$ SW $\frac{1}{4}$ " or footage from lines SE SE SW
Lease Owner B & R Drilling, Inc.
Lease Name Harding Well No. 1
Office Address Russell, Kansas
Character of Well (completed as Oil, Gas or Dry Hole) Oil Well
Date well completed March 4, 1949 19
Application for plugging filed January 17, 1951 Verbally 19
Application for plugging approved January 17, 1951 Verbally 19
Plugging commenced January 18, 1951 19
Plugging completed January 22, 1951 19
Reason for abandonment of well or producing formation All Oil Recovered

NORTH

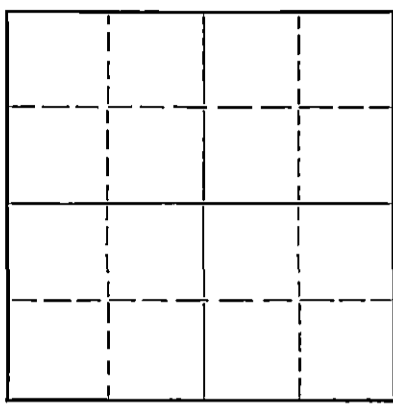

Locate well correctly on above Section Plat

If a producing well is abandoned, date of last production _____ 19
Was permission obtained from the Conservation Division or its agents before plugging was commenced? Yes

Name of Conservation Agent who supervised plugging of this well C. D. Stough
Producing formation _____ Depth to top _____ Bottom _____ Total Depth of Well 4271' Feet
Show depth and thickness of all water, oil and gas formations.

OIL, GAS OR WATER RECORDS

CASING RECORD

Formation	Content	From	To	Size	Put In	Pulled Out
				8 5/8"	333'	None
				5 1/2"	4241'	3448'

Describe in detail the manner in which the well was plugged, indicating where the mud fluid was placed and the method or methods used in introducing it into the hole. If cement or other plugs were used, state the character of same and depth placed, from _____ feet to _____ feet for each plug set.

Plugging Record.

Plugged back with crushed rock to 3625',
dumped 5 sax cement at 3625' with dump bailer.
top of cement 3590'. Filled with mud to 250'
Set rock bridge, dumped 15 sax cement, top of
cement 205'. Filled with mud to 30', set rock
bridge, dumped 10 sax cement for cap.

FFB 3-5-51
CONS. DIV. STATE
WICHITA, KANSAS

(If additional description is necessary, use BACK of this sheet)

Correspondence regarding this well should be addressed to B & R Drilling, Inc.
Address Russell, Kansas

STATE OF Kansas COUNTY OF Russell, ss.
W. A. Michaelis, Jr. (employee of owner) or (owner or operator) of the above-described well,

being first duly sworn on oath, says: That I have knowledge of the facts, statements, and matters herein contained and the log of the above-described well as filed and that the same are true and correct. So help me God.

(Signature) W. A. Michaelis, Jr.
Russell, Kansas (Address)

SUBSCRIBED AND SWORN to before me this 1st day of February, 1951

Wm. Lamm
Notary Public.

My commission expires 6-17-54

PLUGGING
FILE SEC 7 T 28 R 11 E
BOOK PAGE 58 LINE 17

B & R Drilling, Inc.
Harding #1

Sec. 7 Twp. 28 Range. 11
Pratt County, Kansas

Total Depth: 4271'
Comm: 2-7-49
Comp: 3-4-49

Top Viola - 4239'

Casing
8 5/8" Set @ 333'
5 1/2" Set @ 4241'

Cement
250 sacks
150 Sacks

Formation	Depth
Surface Soil	20
Sand-Shale	60
Shale-Shells	100
Shale-Sand	180
Red Shale	275
Shale-Shells	330
Red Bed	430
Red Bed-shells	740
Shale-Shells	1275
Shale-Shells-Salt	1425
Shale-Shells	1515
Lime	1925
Lime-Shale	2070
Lime	2470
Shale-Lime	3400
Lime	3575
Lime-Shale	3597
Lime	4203
Lime-Shale	4232
Lime	4271

STATE OF KANSAS)
Russell County) SS

RECEIVED
STATE CORPORATION COMMISSION
FEB 3 1951
CONSERVATION DIVISION
Wichita, Kansas

I hereby certify that the above information is true and correct to the best of my knowledge.

Violet Keller

Subscribed and sworn to before me this 1st day of February, 1951

Clara Sumner

Notary Public

My commission expires: 6-17-54

DRILLING
FILE SEC 7 T 28 R 11 G
BOOK PAGE 58 LINE 12