


STATE OF KANSAS  
STATE CORPORATION COMMISSION

Form CP-4

Give All Information Completely  
Make Required Affidavit  
Mail or Deliver Report to:  
Conservation Division  
State Corporation Commission  
212 No. Market  
Wichita, Kansas

## WELL PLUGGING RECORD

NORTH

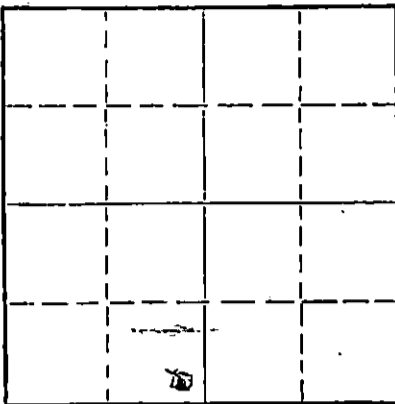

Locate well correctly on above  
Section Plat

Pratt County. Sec. 7 Twp. 18 Rge. 11 W (E) (W)  
Location as "NE/CNW/SW" or footage from lines 330 from E. Line - 330 from D. Line  
Lease Owner E. E. Bickford  
Lease Name Harding #1 Well No. 11  
Office Address 144 N. Westfield - Wichita, Kansas  
Character of Well (completed as Oil, Gas or Dry Hole) Rework  
Date well completed \_\_\_\_\_ 19\_\_\_\_  
Application for plugging filed Dec. 6 1966  
Application for plugging approved Dec. 6 1966  
Plugging commenced Nov. 30 1966  
Plugging completed Nov. 30 19\_\_\_\_  
Reason for abandonment of well or producing formation Dry

If a producing well is abandoned, date of last production No Production 19\_\_\_\_  
Was permission obtained from the Conservation Division or its agents before plugging was commenced? yes

Name of Conservation Agent who supervised plugging of this well Archie P. Livingston  
Producing formation \_\_\_\_\_ Depth to top 3800 Bottom 3800 Total Depth of Well 3800 Feet  
Show depth and thickness of all water, oil and gas formations. Not Known

## OIL, GAS OR WATER RECORDS

## CASING RECORD

| FORMATION               | CONTENT | FROM        | TO | SIZE        | PUT IN      | PULLED OUT  |
|-------------------------|---------|-------------|----|-------------|-------------|-------------|
| <u>Kansas City Lime</u> |         | <u>3600</u> |    | <u>3800</u> | <u>3800</u> | <u>3600</u> |
|                         |         |             |    |             |             |             |
|                         |         |             |    |             |             |             |
Describe in detail the manner in which the well was plugged, indicating where the mud fluid was placed and the method or methods used in introducing it into the hole. If cement or other plugs were used, state the character of same and depth placed, from 3800 feet to 3600 feet for each plug set.

Pumped full of 40 sacks of Drilling Mud + 80 Sacks Cement

RECEIVED  
STATE CORPORATION COMMISSION

DEC 19 1966

12-19-66

CONSERVATION DIVISION  
Wichita, Kansas

Name of Plugging Contractor Glenwood Smith Pipe Pulling Company  
Address Glenwood, Kansas

STATE OF Kansas, COUNTY OF Sedgwick, ss.

(employee of owner) or (owner or operator) of the above-described well, being first duly sworn on oath, says: That I have knowledge of the facts, statements, and matters herein contained and the log of the above-described well as filed and that the same are true and correct. So help me God.

(Signature)

E. E. Bickford

SUBSCRIBED AND SWORN TO before me this 19th day of December, 1966

144 N. Westfield - Wichita  
Deward S. Greener  
(Address)

Notary Public.

My commission expires

November 5, 1967