


STATE OF KANSAS  
STATE CORPORATION COMMISSION

WELL PLUGGING RECORD

Give All Information Completely  
Make Required Affidavit  
Mail or Deliver Report to:  
Conservation Division  
State Corporation Commission  
211 No. Broadway  
Wichita, Kansas

Meade County, Sec. 7 Twp. 32S Rge. (E) 27 (W)  
Location as "NE/CNWSW" or footage from lines C W/2 NW/4

Lease Owner Lee Banks  
Lease Name Isaac Well No. 1  
Office Address 360 Sutton Place, Wichita, KS 67202  
Character of Well (completed as Oil, Gas or Dry Hole) D & A  
Date well completed 2 August 19 78  
Application for plugging filed 2 August 19 78  
Application for plugging approved 2 August 19 78  
Plugging commenced 2 August 19 78  
Plugging completed 2 August 19 78  
Reason for abandonment of well or producing formation dry hole

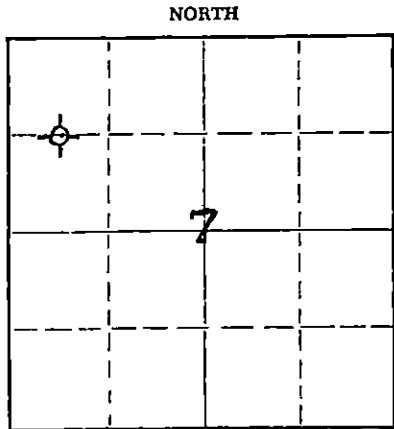

Locate well correctly on above Section Plat

If a producing well is abandoned, date of last production 19  
Was permission obtained from the Conservation Division or its agents before plugging was commenced? yes

Name of Conservation Agent who supervised plugging of this well Duane L. Rankin  
Producing formation \_\_\_\_\_ Depth to top \_\_\_\_\_ Bottom \_\_\_\_\_ Total Depth of Well 5520 Feet  
Show depth and thickness of all water, oil and gas formations.

OIL, GAS OR WATER RECORDS				CASING RECORD		
FORMATION	CONTENT	FROM	TO	SIZE	PUT IN	PULLED OUT

Describe in detail the manner in which the well was plugged, indicating where the mud fluid was placed and the method or methods used in introducing it into the hole. If cement or other plugs were used, state the character of same and depth placed, from \_\_\_\_\_ feet to \_\_\_\_\_ feet for each plug set.  
Spot 50 sx plug at 1200'  
35 sx at 600'  
12 sx at 0-40'  
3 sx Rat Hole

RECEIVED  
STATE CORPORATION COMMISSION  
AUG 10 1978  
8-10-78  
CONSERVATION DIVISION  
Wichita, Kansas

(If additional description is necessary, use BACK of this sheet)  
Name of Plugging Contractor Gabbert-Jones, Inc.  
Address 820 Sutton Place, Wichita, KS 67202

STATE OF KANSAS, COUNTY OF SEDGWICK, ss.  
Lee Banks (employee of owner) or (owner or operator) of the above-described well, being first duly sworn on oath, says: That I have knowledge of the facts, statements, and matters herein contained and the log of the above-described well as filed and that the same are true and correct. So help me God.

(Signature) Lee Banks  
360 Sutton Place, Wichita, KS 67202  
(Address)

SUBSCRIBED AND SWORN TO before me this 9th day of August, 19 78

My commission expires  
KATHERINE A. KUHN  
STATE NOTARY PUBLIC  
Sedgwick County, Kansas  
My Appt. Exp. 7-2-80

Katherine A. Kuhns  
Katherine A. Kuhns  
Notary Public.

GABBERT-JONES, INC.  
 WICHITA, KANSAS  
 DRILLERS' WELL LOG

Isaac #1  
 C-W/2-NW/4 Sec 7-32S-27W  
 Meade County Kansas

Commenced: 7-21-78

Completed: 8-2-78

OPERATOR: BANKS OIL CO.

From	Depth to	Formation	Remarks
0	790	Sand Redbed	Ran 35 jts of 23# 8 5/8" csg
790	1380	Redbed	set @ 1379' Cemented w/
1380	1630	Sand-Redbed	550 sks Halcolite 2% CC
1630	2040	Redbed-Sand	1/2 Flocele - 150 sks Class H
2040	2640	Sand-Shale	3% CC PD @ 1:00 p.m. 7-22-78
2640	3020	Shale	
3020	3216	Shale-Lime	
3216	3640	Shale	
3640	4078	Shale-Lime	
4078	4215	Lime-Shale	
4215	4476	Shale-Lime	
4476	4835	Lime-Shale	
4835	4477	Shale-Lime	
4477	4960	Lime-Shale	
4960	5050	Shale-Lime	
5050	5398	Lime-Shale	
5398	5446	Lime-Shale-Sand	
5446	5520	Lime-Shale	
	5520 - TD		DRY & ABANDONED

STATE OF KANSAS )  
 ) SS  
 COUNTY OF BEDGWICK)

I, the undersigned, being duly sworn on oath, state that the above Drillers' Well Log is true and correct to the best of my knowledge and belief and according to the records of this office.

GABBERT-JONES, INC.

*James S. Sutton II*  
 JAMES S. SUTTON II

Subscribed and sworn to before me this 8th day of August, 1978.

*Elizabeth J. Edwards*  
 ELIZABETH J. EDWARDS-NOTARY PUBLIC

My Commission expires February 6, 1979.

RECEIVED  
 STATE CORPORATION COMMISSION

AUG 10 1978

CONSERVATION DIVISION  
 Wichita, Kansas

