


STATE OF KANSAS
STATE CORPORATION COMMISSION

WELL PLUGGING RECORD

Give All Information Completely
Make Required Affidavit
Mail or Deliver Report to
Conservation Division
State Corporation Comm.
245 North Water
Wichita, KS 67202

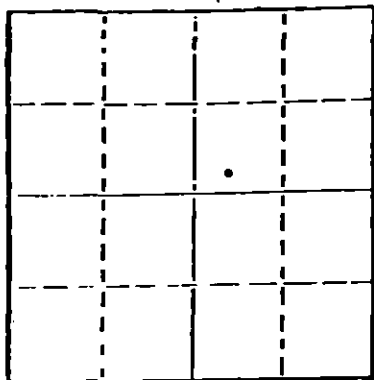

Locate well correctly on above
Section Plot

Meade County. Sec. 8 Twp. 32 Rge. 27 ~~NE~~W
Location as "NE/CNW $\frac{1}{4}$ SW $\frac{1}{4}$ " or footage from lines _____
SW SW NE
Lease Owner BMG
Lease Name Collingwood OWWO Well No. 1
Office Address Bx1546, Liberal, Kansas, 67901
Character of Well (Completed as Oil, Gas or Dry Hole) _____
Dry hole
Date Well completed _____ 19____
Application for plugging filed April 7, _____ 1976
Application for plugging approved April 9, _____ 1976
Plugging commenced 4-9-1976 _____ 19____
Plugging completed 4-12 _____ 1976
Reason for abandonment of well or producing formation _____
Non Productive
If a producing well is abandoned, date of last production _____ 19____

Was permission obtained from the Conservation Division or its agents before plugging was commenced? Yes

Name of Conservation Agent who supervised plugging of this well Mr. Thomas
Producing formation _____ Depth to top _____ Bottom _____ Total Depth of Well 3743
Show depth and thickness of all water, oil and gas formations.

OIL, GAS OR WATER RECORDS

CASING RECORD

FORMATION	CONTENT	FROM	TO	SIZE	PUT IN	PULLED OUT
				16"	350'	None
				9 3/4"	2640'	None
				4 1/2"	3923'	2447'

Describe in detail the manner in which the well was plugged, indicating where the mud fluid was placed and the method or methods used in introducing it into the hold. If cement or other plugs were used, state the character of same and depth placed, from _____ feet to _____ feet for each plug set.

Pumped 2 sacks hulls & 15 sacks cement to 2850'

Mud from 2850' to 2250'

Pumped 35 sacks cement 2250' to 2150'

Mud 2150' to 45'

Put bridge & 15 sacks cement 45' to 0'

RECEIVED
STATE CORPORATION COMMISSION
APR 23 1976
4-23-76
CONSERVATION DIVISION
Wichita, Kansas

(If additional description is necessary, use BACK of this sheet)

Name of Plugging Contractor Midwest Casing Pulling
Box F, Sublette, Kansas 67901

STATE OF COLORADO COUNTY OF DENVER ss.
JAMES JAMESON (employee of owner) or (owner or operator) of the above-described

well, being first duly sworn on oath, says: That I have knowledge of the facts, statements, and matters herein contained and the log of the above-described well as filed and that the same are true and correct. So help me God.

(Signature) James Jameson
1400 Metrobank Bldg., Denver, Co.
(Address)

Subscribed and sworn to before me this 22 day of April 19 76

My commission expires Dec. 18, 1978

Gerardine Lancia
Notary Public.