


WELL PLUGGING RECORD

Give All Information Completely
Make Required Affidavit
Mail or Deliver Report to:
Conservation Division
State Corporation Commission
800 Bittling Building
Wichita, Kansas

Meade County, Sec. 29 Twp. 32 Rge. 27 (E) (W)
Location as "NE/CNW $\frac{1}{4}$ SW $\frac{1}{4}$ " or footage from lines NW SE NW
Lease Owner Colorado Oil & Gas Corporation
Lease Name Bartel Well No. 1
Office Address P. O. Box 999, Liberal, Kas.
Character of Well (completed as Oil, Gas or Dry Hole) Dry Hole
Date well completed February 20, 1956 19
Application for plugging filed Yes 19
Application for plugging approved Yes 19
Plugging commenced February 21, 1956 19
Plugging completed February 21, 1956 19
Reason for abandonment of well or producing formation Dry Hole

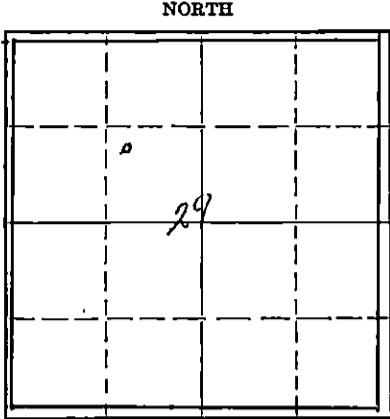

Locate well correctly on above Section Plat

If a producing well is abandoned, date of last production - 19
Was permission obtained from the Conservation Division or its agents before plugging was commenced? Yes

Name of Conservation Agent who supervised plugging of this well M. A. Rives
Producing formation None Depth to top Bottom Total Depth of Well 5940 Feet
Show depth and thickness of all water, oil and gas formations.

OIL, GAS OR WATER RECORDS

CASING RECORD

Formation	Content	From	To	Size	Put In	Pulled Out
				13 3/8"	506	None
				8 5/8"	2621	1993'

Describe in detail the manner in which the well was plugged, indicating where the mud fluid was placed and the method or methods used in introducing it into the hole. If cement or other plugs were used, state the character of same and depth placed, from feet to feet for each plug set.

Set 8 5/8" X 14" plug at 2569' spotted 50 sx cement on top of plug.
Shot off 8 5/8" casing at 1993' and pulled. Filled hole with mud.
Set 13 3/8" X 14" plug at 472' spotted 35 sx cement on top of plug.
Filled with mud, set 13 3/8" X 14" plug at 30'. Filled with cement to bottom of cellar. Complete 12:15 PM.

RECEIVED
STATE CORPORATION COMMISSION
FEB 24 1956
2-24-56
CONSERVATION DIVISION
Wichita, Kansas

(If additional description is necessary, use BACK of this sheet)
Name of Plugging Contractor Mid-Western Drillers Inc.
Address Liberal, Kas.

STATE OF Kansas, COUNTY OF Seward, ss.
(employee of owner) or (owner or operator) of the above-described well,

being first duly sworn on oath, says: That I have knowledge of the facts, statements, and matters herein contained and the log of the above-described well as filed and that the same are true and correct. So help me God.

(Signature) [Signature]
P. O. Box 999, Liberal, Kansas (Address)

SUBSCRIBED AND SWORN to before me this 23 day of February, 1956
William B. Claunch
Notary Public.

My commission expires 11-1-58

PLUGGING
FILE SEC 29 T 32 R 27W
BOOK PAGE 41 LINE 16

15-119-00033-00-00

WELL LOG

0 - 125	Surface Sands
125 - 1975	Red beds w/anhydrite, Gyp and salt stringers w/sanded base
1975 - 2030	Anhydrite
2030 - 2590	Red beds w/anhydrite
2590 - 2620	Dolomite w/anhydrite and shale stringers
2620 - 3900	Limestone w/dolomite and shale stringers
3900 - 4375	Shale w/limestone stringers
4375 - 4515	Limestone
4515 - 4575	Shale
4575 - 5600	Limestone w/shale stringers
5600 - 5635	Shale
5635 - 5810	Limestone w/shale stringers
5810 - 5940	Limestone vari-colored shale stringers

RECEIVED
STATE GEOLOGICAL DEPARTMENT
FEB 24 1956
CONSERVATION DIVISION
Wichita, Kansas

PLUGGING
FILE SEC 29 22 27w
BOOK PAGE 41 LINE 16