

15-119-10081-100-00


STATE OF KANSAS
STATE CORPORATION COMMISSION

Give All Information Completely
Make Required Affidavit
Mail or Deliver Report to:
Conservation Division
State Corporation Commission
211 No. Broadway
Wichita, Kansas

WELL PLUGGING RECORD

Meade County, Sec. 33 Twp. 32 Rge. (E) 27 (W)
Location as "NE/CNW $\frac{1}{4}$ SW $\frac{1}{4}$ " or footage from lines C SE/4
Lease Owner Graham-Michaelis Drilling Company
Lease Name Reimer Well No. 1-33
Office Address 211 North Broadway, Wichita 2, Kansas
Character of Well (completed as Oil, Gas or Dry Hole) Dry Hole
Date well completed December 20, 19 60
Application for plugging filed December 21, 19 60
Application for plugging approved December 22, 19 60
Plugging commenced December 21 19 60
Plugging completed December 21 19 60
Reason for abandonment of well or producing formation Dry Hole

NORTH

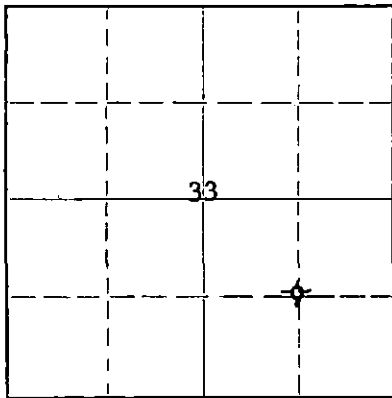

Locate well correctly on above
Section Plat

If a producing well is abandoned, date of last production _____ 19____
Was permission obtained from the Conservation Division or its agents before plugging was commenced? yes

Name of Conservation Agent who supervised plugging of this well Bill LaCkamp, Stafford Kans.
Producing formation none Depth to top _____ Bottom _____ Total Depth of Well 5710 Feet
Show depth and thickness of all water, oil and gas formations.

OIL, GAS OR WATER RECORDS

CASING RECORD

FORMATION	CONTENT	FROM	TO	SIZE	PUT IN	PULLED OUT
				8 5/8	@ 1247'	none

Describe in detail the manner in which the well was plugged, indicating where the mud fluid was placed and the method or methods used in introducing it into the hole. If cement or other plugs were used, state the character of same and depth placed, from _____ feet to _____ feet for each plug set.

Plug at 700' with 30 sacks common cement. Mud to 40', plug and 20 sacks cement on top.

RECEIVED
STATE CORPORATION COMMISSION
JAN 12 1961
1-12-61
CONSERVATION DIVISION
Wichita, Kansas

Driller's Log Attached

(If additional description is necessary, use BACK of this sheet)

Name of Plugging Contractor Graham-Michaelis Drilling Company
Address 211 North Broadway, Wichita 2, Kansas

STATE OF KANSAS, COUNTY OF SEDGWICK, ss.
_____(employee of owner) or (owner or operator) of the above-described well, being first duly sworn on oath, says: That I have knowledge of the facts, statements, and matters herein contained and the log of the above-described well as filed and that the same are true and correct. So help me God.

(Signature) Jack L. Finger
211 North Broadway, Wichita 2, Kansas
(Address)

SUBSCRIBED AND SWORN TO before me this 11 day of January, 19 61

My commission expires August 25, 1964
A. B. Burgen
A. B. Burgen Notary Public.

REIMER #1-33

WELL RECORD:

LOCATION:

C SE/4 Section 33-32-27
Meade County, Kansas

Commenced: 12/2/60
Completed: 12/21/60
(Rotary)

CONTRACTOR:

Graham-Michaelis Drilling Co.
Liberal Division
Box 896
Liberal, Kansas

CASING RECORD:

40 Jts. 8 5/8" J-55 24# Casing
cemented w/500 sx Trinity Lite
Wt. 2% cc followed w/200 sx
Common 2% cc
Reacement top of surface thru
1" w/100 sx Sunset

	<u>LOG</u>	
Red Bed	0 -	40
Sand & Clay	40 -	310
Red Bed & Gyp	310 -	620
Red Bed, Gyp & Sand	620 -	1410
Shale & Anhy	1410 -	1659
Shale, Salt & Lime Shells	1659 -	2020
Shale & Lime	2020 -	2860
Lime	2860 -	2996
Lime & Shale	2996 -	3500
Shale	3500 -	3675
Shale & Lime	3675 -	4144
Lime	4144 -	4230
Shale & Lime	4230 -	4721
Lime	4721 -	5710

RECEIVED
STATE COMMISSION

JAN 12 1961

CONSERVATION DIVISION
Wichita, Kansas

5710' - Total Rotary Depth

The undersigned, Graham-Michaelis Drilling Company, Liberal Division, certifies that the above log is a true and correct copy of the formations encountered in drilling the above mentioned well, as taken from the Daily Drilling Report.

GRAHAM-MICHAELIS DRILLING COMPANY
LIBERAL DIVISION

By 
H. R. Michaelis