


STATE OF KANSAS  
STATE CORPORATION COMMISSION

## WELL PLUGGING RECORD

Give All Information Completely  
Make Required Affidavit  
Mail or Deliver Report to  
Conservation Division  
State Corporation Comm.  
245 North Water  
Wichita, KS 67202

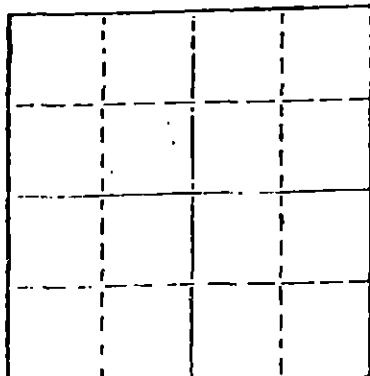

Locate well correctly on above  
Section Plat

Meade County, Sec. 35 Twp. 32S Rge. 27W E/W  
Location as "NE/CNW/SW" or footage from lines  
1250' FSL 1650' FWL  
Lease Owner Texas Oil & Gas Corp.  
Lease Name Loewen "A" Well No. 1  
Office Address 200 W. Douglas Suite 300 Wichita, Kansas 67202  
Character of Well (Completed as Oil, Gas or Dry Hole) Gas  
Date Well completed 19  
Application for plugging filed 7-9 1979  
Application for plugging approved 7-11 1979  
Plugging commenced 8-23 1979  
Plugging completed 8-25 1979  
Reason for abandonment of well or producing formation

If a producing well is abandoned, date of last production 19

Was permission obtained from the Conservation Division or  
its agents before plugging was commenced? Yes

Name of Conservation Agent who supervised plugging of this well Clarence Thomas  
Producing formation Depth to top Bottom Total Depth of Well 5750  
Show depth and thickness of all water, oil and gas formations.

## OIL, GAS OR WATER RECORDS

## CASING RECORD

FORMATION	CONTENT	FROM	TO	SIZE	PUT IN	PULLED OUT
				9 5/8	1541	none
				4 1/2	5757	

Describe in detail the manner in which the well was plugged, indicating where the mud fluid  
was placed and the method or methods used in introducing it into the hold. If cement or other  
plugs were used, state the character of same and depth placed, from feet to  
feet for each plug set.

Pump 15 sks. of cement @ 5727 to 5505

Pump 50 sks. of cement @ 1591 to 1491

Put 10 sks. of cement @ 40 to 0

(If additional description is necessary, use BACK of this sheet)

Name of Plugging Contractor Sargent's Casing Pulling service Box 506 Liberal, Kansas 67901

STATE OF KANSAS COUNTY OF SEDGWICK, ss.  
GARY E. WURDEMAN (employee of owner) or (owner or operator)  
of the above-described well, being first duly sworn on oath, says: That I have knowledge of  
the facts, statements, and matters herein contained and the log of the above-described well  
as filed and that the same are true and correct. So help me God.

(Signature)

200 West Douglas, Suite 300, Wichita, KS. 67202  
(Address)

SUBSCRIBED AND SWORN TO before me this 1st day of October, 1979

Kathy Faye Blick  
KATHY FAYE BLICK Notary Public.

My commission expires October 29, 1982



RECEIVED  
STATE CORPORATION COMMISSION


OCT - 2 1979  
10-21-79  
Conservation Division  
Wichita, Kansas

WELL: LOEWEN A

15-119-10170-00-01

LOCATION: 1250' FSL - 1650' FWL Sec. 35-32S-27W MEADE Co, KS

LOCATION: 2429' G.L. 2437' K.B.

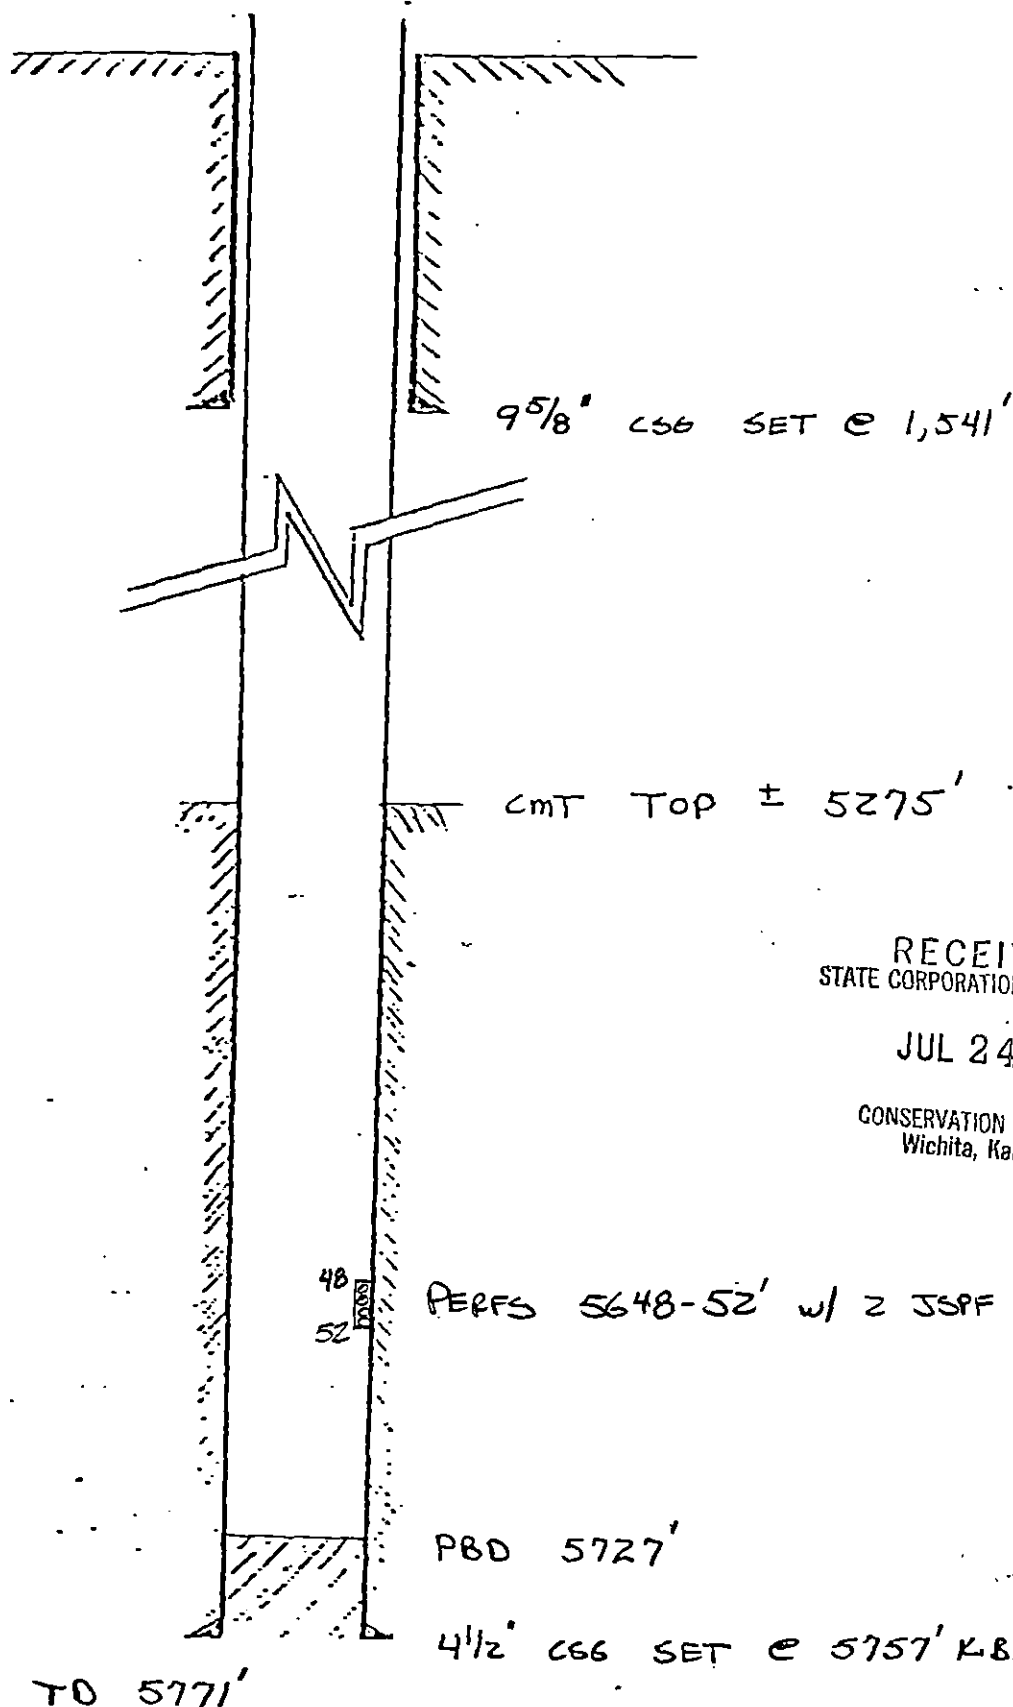

RECEIVED  
STATE CORPORATION COMMISSION

JUL 24 1979

CONSERVATION DIVISION  
Wichita, Kansas