


Give All Information Completely
Make Required Affidavit
Mail or Deliver Report to:
Conservation Division
State Corporation Commission
211 No. Broadway
Wichita, Kansas

WELL PLUGGING RECORD

Meade County. Sec. 22 Twp. 32S Rge. (E) 28 (W)
Location as "NE/CNW/SW" or footage from lines C NE/4
Lease Owner Lee Banks
Lease Name Ross Well No. 1
Office Address 360 Sutton Place, Wichita, KS 67202
Character of Well (completed as Oil, Gas or Dry Hole) dry hole
Date well completed 19 July 19 78
Application for plugging filed 27 July 19 78
Application for plugging approved 19 July 19 78
Plugging commenced 19 July 19 78
Plugging completed 19 July 19 78
Reason for abandonment of well or producing formation dry hole

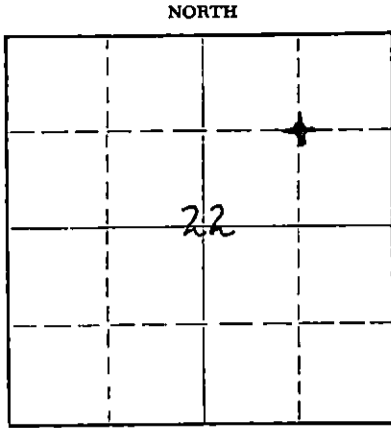

Locate well correctly on above Section Plat

If a producing well is abandoned, date of last production 19
Was permission obtained from the Conservation Division or its agents before plugging was commenced? Yes

Name of Conservation Agent who supervised plugging of this well William T. Owen, Pratt, KS
Producing formation none Depth to top Bottom Total Depth of Well 5600' Feet
Show depth and thickness of all water, oil and gas formations.

OIL, GAS OR WATER RECORDS

CASING RECORD

FORMATION	CONTENT	FROM	TO	SIZE	PUT IN	PULLED OUT

Describe in detail the manner in which the well was plugged, indicating where the mud fluid was placed and the method or methods used in introducing it into the hole. If cement or other plugs were used, state the character of same and depth placed, from feet to feet for each plug set.

Plug @ 1200' - w/50 sx. cement
Plug @ 600' - w/35 sx. cement
Plug @ 40' - w/12 sx. cement

RECEIVED
STATE CORPORATION COMMISSION
JUL 28 1978
7-28-78
CONSERVATION DIVISION
Wichita, Kansas

(If additional description is necessary, use BACK of this sheet)
Name of Plugging Contractor Gabbert-Jones, Inc.
Address 820 Sutton Place, Wichita, KS 67202

STATE OF KANSAS, COUNTY OF SEDGWICK, ss.
Lee Banks (employee of owner) or (owner or operator) of the above-described well, being first duly sworn on oath, says: That I have knowledge of the facts, statements, and matters herein contained and the log of the above-described well as filed and that the same are true and correct. So help me God.

(Signature) Lee Banks
360 Sutton Place, Wichita, KS 67202
(Address)

SUBSCRIBED AND SWORN TO before me this 27th day of July, 19 78

KATHERINE A. KUHN
Katherine A. Kuhns Notary Public.

My commission expires
KATHERINE A. KUHN
STATE NOTARY PUBLIC
Sedgwick County, Kansas
My Appt. Exp. 7-2-80

15-119-20316-00-00

GABBERT-JONES, INC.
WICHITA, KANSAS
DRILLERS' WELL LOG

Ross #1
C-NE/4 Sec 22-32S-28W
Meade County Kansas

Commenced: 7-5-78

Completed: 7-19-78

OPERATOR: BANKS OIL CO.

Depth		Formation	Remarks
From	to		
0	240	SAnd	Ran 34 jts of 24# 8 5/8" csg
240	750	Sand-Redbed	set @ 1324' KB Cemented
750	1325	Redbed-Sand	w/550 sks H. L. 2% CC
1325	2066	SAnd-Shale	1/2# Flocele + 150 sks
2066	2552	Lime-Shale	Class H 3% CC
2552	2784	Shale-Lime	PD @ 5:05 a.m. 7-7-78
2784	2973	Shale	
2973	3163	Lime-Shale	
3163	3386	Shale-Lime	
3386	4195	Shale	
4195	4338	Shale-Lime	
4338	4490	Lime-Shale	
4490	4614	Shale-Lime	
4614	4812	Lime-Shale	DRY & ABANDONED
4812	4910	Shale-Lime	
4910	5078	Lime-Shale	
5078	5167	Shale-Lime	
5167	5245	Lime-Shale	
5245	5396	Shale-Lime	
5396	5444	Lime-Shale	
5444	5530	Lime	
5530	5542	Lime-Shale	
5542	5600	Lime	
	5600 - TD		

STATE OF KANSAS)
) SS
COUNTY OF SEDGWICK)

RECEIVED
STATE CORPORATION COMMISSION

JUL 28 1978

CONSERVATION DIVISION
Wichita, Kansas

I, the undersigned, being duly sworn on oath, state that the above Drillers' Well Log is true and correct to the best of my knowledge and belief and according to the records of this office.

GABBERT-JONES, INC.

[Signature]
JAMES S. SUTTON II

Subscribed and sworn to before me this 25th day of July, 1978.

[Signature]
ELIZABETH J. EDWARDS-NOTARY PUBLIC

My Commission expires February 6, 1978.

