

15-119-10165-00-00


STATE OF KANSAS  
STATE CORPORATION COMMISSION

Give All Information Completely  
Make Required Affidavit  
Mail or Deliver Report to:  
Conservation Division  
State Corporation Commission  
212 North Market, Insurance Bldg.  
Wichita, Kansas

WELL PLUGGING RECORD

Meade County, Sec. <sup>27</sup> 24 Twp. 32S Rge. 28 (E) (W)  
Location as "NE/CNW/SW" or footage from lines 660' from south and west lines  
Lease Owner The Shamrock Oil and Gas Corporation  
Lease Name E. W. McNaghten et al "A" Well No. 1  
Office Address Box 631, Amarillo, Texas  
Character of Well (completed as Oil, Gas or Dry Hole) Dry Hole  
Date well completed 7-10 19 60  
Application for plugging filed 7-10 19 60  
Application for plugging approved 7-10 19 60  
Plugging commenced 7-11 19 60  
Plugging completed 7-11 19 60  
Reason for abandonment of well or producing formation Dry

NORTH

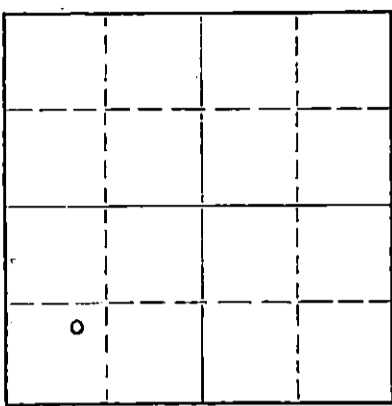

Locate well correctly on above Section Flat

If a producing well is abandoned, date of last production — 19 —  
Was permission obtained from the Conservation Division or its agents before plugging was commenced? Yes

Name of Conservation Agent who supervised plugging of this well Bill Lackamp, Jr., Stafford, Kansas  
Producing formation None Depth to top — Bottom — Total Depth of Well 5,582 Feet  
Show depth and thickness of all water, oil and gas formations.

OIL, GAS OR WATER RECORDS

CASING RECORD

FORMATION	CONTENT	FROM	TO	SIZE	PUT IN	PULLED OUT
Sand and shells	Water	0	98	10 3/4"	1,560	-0-

Describe in detail the manner in which the well was plugged, indicating where the mud fluid was placed and the method or methods used in introducing it into the hole. If cement or other plugs were used, state the character of same and depth placed, from — feet to — feet for each plug set.  
Filled hole with heavy mud to 1,500'. Pushed 10 3/4" Halliburton plug to 1,500'. Spotted 25 sacks cement on plug. Filled hole to 600' with heavy mud. Pushed plug to 600'. Spotted 30 sacks cement on plug. Filled hole to 35' with heavy mud. Filled hole with 35 sacks cement to base of cellar.

RECEIVED  
STATE CORPORATION COMMISSION  
JUL 13 1960  
7-13-60  
CONSERVATION DIVISION  
Wichita, Kansas

(If additional description is necessary, use BACK of this sheet)  
Name of Plugging Contractor Halliburton Oil Well Cementing Company  
Address Liberal, Kansas

STATE OF Texas, COUNTY OF Potter, ss.  
T. S. Clopton (employee of owner) or (owner) of the above-described well, being first duly sworn on oath, says: That I have knowledge of the facts, statements, and matters herein contained and the log of the above-described well as filed and that the same are true and correct. So help me God.

(Signature) T. S. Clopton  
Box 631, Amarillo, Texas (Address)

SUBSCRIBED AND SWORN TO before me this 12th day of July, 19 60

PAULINE POWELL  
Notary Public  
Potter County, Texas  
Notary Public.

My commission expires 6-1-61

15-119-10165-00-00

E. W. MCNAGHTEN ET AL "A" NO. 1  
Section 27, Township 32 South, Range 28 West  
Meade, County, Kansas

0' - 98'	Sand and shells
98' - 742'	Sand, clay, shells, and red bed
742' - 1,080'	Red bed, sand, and shale.
1,080' - 2,440'	Shale and shells
2,440' - 4,616'	Lime and shale
4,616' - 4,662'	Lime
4,662' - 4,685'	Lime and shale
4,685' - 4,770'	Lime
4,770' - 4,875'	Lime and shale
4,875' - 4,903'	Lime
4,903' - 4,973'	Lime and shale
4,973' - 5,012'	Lime
5,012' - 5,477'	Lime and shale
5,477' - 5,582'	Lime

RECEIVED  
STATE CORPORATION COMMISSION

JUL 13 1960

CONSERVATION DIVISION  
Wichita, Kansas