

WELL PLUGGING RECORD

Give All Information Completely
Make Required Affidavit
Mail or Deliver Report to:
Conservation Division
State Corporation Commission
212 No. Market
Wichita, Kansas

Meade County, Sec. 28 Twp. 32 Rge. 28 (X) (W)

Location as "NE/CNW/SW" or footage from lines C E/2 SW SE

Lease Owner Zenith Drilling Corporation, Inc.

Lease Name Cunningham Well No. 1

Office Address Suite 600, 200 W. Douglas, Wichita, Kansas

Character of Well (completed as Oil, Gas or Dry Hole) dry hole

Date well completed April 10 19 74

Application for plugging filed April 10 19 74

Application for plugging approved April 10 19 74


Plugging commenced April 10 19 74

Plugging completed April 10 19 74

Reason for abandonment of well or producing formation

If a producing well is abandoned, date of last production 19

Was permission obtained from the Conservation Division or its agents before plugging was commenced? yes

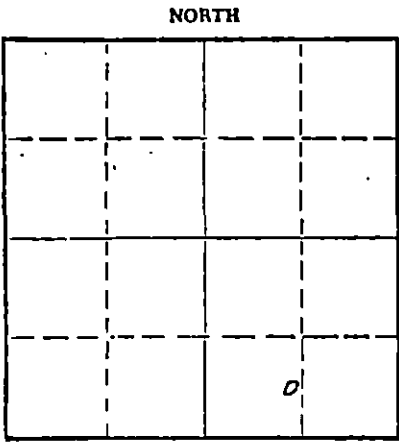

Locate well correctly on above Section Flat

Name of Conservation Agent who supervised plugging of this well

Producing formation Depth to top Bottom Total Depth of Well 4840 Feet

Show depth and thickness of all water, oil and gas formations.

OIL, GAS OR WATER RECORDS

CASING RECORD

| FORMATION | CONTENT | FROM | TO | SIZE | PUT IN | PULLED OUT |
|-----------|---------|------|----|--------|--------|------------|
| | | | | 8 5/8" | 735' | |
| | | | | | | |
| | | | | | | |
| | | | | | | |
| | | | | | | |
| | | | | | | |
| | | | | | | |
| | | | | | | |
| | | | | | | |

Describe in detail the manner in which the well was plugged, indicating where the mud fluid was placed and the method or methods used in introducing it into the hole. If cement or other plugs were used, state the character of same and depth placed, from feet to feet for each plug set.

35 sx 700/600'
15 sx 45/0'

RECEIVED
STATE CORPORATION COMMISSION
APR 23 1974
23-74
CONSERVATION DIVISION
Wichita, Kansas

(If additional description is necessary, use BACK of this sheet)

Name of Plugging Contractor Zenith Drilling Corporation, Inc.

Address Suite 600, 200 West Douglas, Wichita, Kansas

STATE OF Kansas, COUNTY OF Sedgwick, ss.

C. Robert Buford (employee of owner) or (owner or operator) of the above-described well, being first duly sworn on oath, says: That I have knowledge of the facts, statements, and matters herein contained and the log of the above-described well as filed and that the same are true and correct. So help me God.

(Signature) C. Robert Buford

Suite 600, 200 W. Douglas, Wichita, Kansas (Address)

SUBSCRIBED AND SWORN to before me this 17th day of April, 19 74

My commission expires August 15, 1975

Myrna D. Murphy Notary Public.

WELL LOG

COMPANY Zenith Drilling Corporation, Inc.

SEC. 28-32-28W

FARM Cunningham NO. 1

LOC. C E/2 SW SE

TOTAL DEPTH 4840'

Meade County, Kansas


COMM. March 30, 1974

COMP. April 9, 1974

CONTRACTOR Zenith Drilling Corporation, Inc.

CASING

Ran 18 jts 8 5/8 cs Total 735' (14-23#, 4-24#) w/450 sx cement.

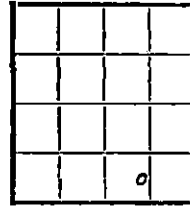

ELEVATION

PRODUCTION Dry hole

FIGURES INDICATE BOTTOM OF FORMATIONS

| | | |
|------|---------|------------------------|
| 0 | 902 | Sand and Clay |
| 902 | 2190 | Redbed & Anhydrite |
| 2190 | 2560 | Redbed & Shale |
| 2560 | 2800 | Shale & Lime |
| 2800 | 2930 | Lime & Shale |
| 2930 | 3116 | Shale & Lime |
| 3116 | 3335 | Shale, Lime & Dolomite |
| 3335 | 3530 | Shale & Lime |
| 3530 | 4275 | Lime & Shale |
| 4275 | 4400 | Lime |
| 4400 | 4565 | Lime & Shale |
| 4565 | 4840 TD | Lime |

RECEIVED
STATE CORPORATION COMMISSION
APR 23 1974
CONSERVATION DIVISION
Wichita, Kansas

State of Kansas }
County of Sedgwick } ss

I, C. Robert Buford of Zenith Drilling Corporation, Inc.

upon oath state the above and foregoing is a true and correct copy of the log of the Cunningham #1 well.

Subscribed and sworn to before me this 17th day of April, 1974

My Commission Expires: August 15, 1975

C. Robert Buford
Myrna D. Murphy
NOTARY PUBLIC