


STATE OF KANSAS
STATE CORPORATION COMMISSION

Give All Information Completely
Make Required Affidavit
Mail or Deliver Report to:
Conservation Division
State Corporation Commission
211 No. Broadway
Wichita, Kansas

15-119-00117-00-00

WELL PLUGGING RECORD

NORTH

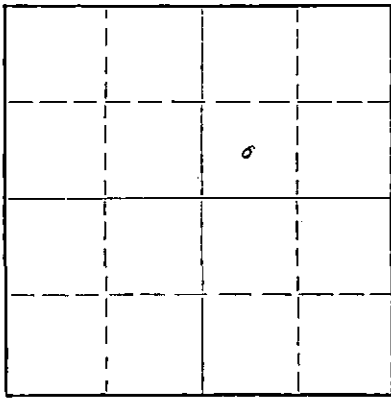

Locate well correctly on above
Section Plat

Meade County, Sec. 30 Twp. 32S Rge. 28W (E) (W)

Location as "NE/CNW/SW" or footage from lines. C NW SE

Lease Owner Sunray Mid-Continent Oil Company

Lease Name Louie Hallock Well No. 1

Office Address 321 W. Douglas, Wichita, 2, Kansas

Character of Well (completed as Oil, Gas or Dry Hole) Dry Hole

Date well completed December 2, 19 60

Application for plugging filed December 5, 19 60

Application for plugging approved December 6, 19 60

Plugging commenced December 2, 19 60

Plugging completed December 2, 19 60

Reason for abandonment of well or producing formation

If a producing well is abandoned, date of last production 19

Was permission obtained from the Conservation Division or its agents before plugging was commenced? Yes

Name of Conservation Agent who supervised plugging of this well Bill Lackamp

Producing formation None Depth to top Bottom Total Depth of Well 5780 Feet

Show depth and thickness of all water, oil and gas formations.

OIL, GAS OR WATER RECORDS

CASING RECORD

FORMATION	CONTENT	FROM	TO	SIZE	PUT IN	PULLED OUT
Mississippi	Dry	5686	5780'	8 5/8"	1520	0
No other development zones.						

Describe in detail the manner in which the well was plugged, indicating where the mud fluid was placed and the method or methods used in introducing it into the hole. If cement or other plugs were used, state the character of same and depth placed, from feet to feet for each plug set.

Filled hole with drilling mud to 1500' and placed 20 sack cement plug. Filled with mud to 550' and placed 20 sack cement plug. Filled with mud to 35' and placed wood plug, 1/2 sack hulls and 10 sack cement to surface. Welded steel plate over surface pipe.

Corrected Report

1-3-61
CONSERVATION DIVISION
Wichita, Kansas

Name of Plugging Contractor Stickle Drilling Company
Address Tulsa, Oklahoma

STATE OF KANSAS, COUNTY OF SEDGWICK, ss. Nash A. Gough (employee of owner) or (owner) of the above-described well, being first duly sworn on oath, says: That I have knowledge of the facts, statements, and matters herein contained and the log of the above-described well as filed and that the same are true and correct. So help me God.

(Signature) *Nash A. Gough*
321 W. Douglas, Wichita 2, Kansas (Address)

SUBSCRIBED AND SWORN TO before me this 15th day of December, 19 60

My commission expires July 13, 1963 Notary Public.

Sunray Mid-Continent Oil Company
Tulsa, Oklahoma

December 8, 1960
Tulsa, Oklahoma

Contractors: Stickie Drilling Company
Date commenced: November 12, 1960
Date completed: December 2, 1960

Louie Hallock No. 1
Ctr. NW SE Sec. 30-32S-28W
Meade County, Kansas

DRILLER'S LOG

DEPTH FIGURES INDICATE BASE OF FORMATION:

Shale	240
Sand	420
Red bed	525
Shale	1040
Red shale	1405
Shale	1525
Shale and shells	1940
Shale	2210
Lime and shale	2465
Lime	2573
Lime and shale	2703
Sandy lime and shale	2823
Lime and shale	3636
Shale and lime	3789
Lime and shale	4170
Shale and lime	4545
Lime and shale	4588
Lime	5384
Sand	5625
Lime and shale	5780 TD

RECEIVED
STATE CORPORATION COMMISSION

DEC 16 1960

CONSERVATION DIVISION
Wichita, Kansas

I, Fred E. Stickie, hereby certify the above to be a true and complete Driller's Log of Sunray Mid-Continent Oil Company's Louie Hallock, Well No. 1, Center of Northwest Quarter (NW 4) of Southeast Quarter (SE 4) of Section 30-32S-28W., Meade County, Kansas.

Fred E. Stickie
Fred E. Stickie

Edith A. Lamer
Notary Public

My Commission expires March 24, 1964.