


STATE OF KANSAS
STATE CORPORATION COMMISSION

Give All Information Completely
Make Required Affidavit
Mail or Deliver Report to:
Conservation Division
State Corporation Commission
211 No. Broadway
Wichita, Kansas

15-119-00117-00-01

WELL PLUGGING RECORD

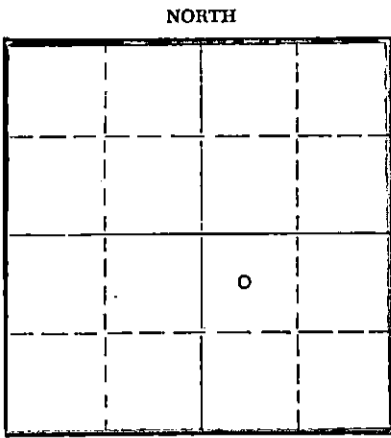

Locate well correctly on above Section Plat

Meade County, Sec. 30 Twp. 32S Rge. 28W (E) (W)
Location as "NE/CNW/SW" or footage from lines C/NW/SE
Lease Owner Horizon Oil & Gas Co.
Lease Name Hallock Well No. 1-30
Office Address P.O. Box 7, Spearman, Texas 79081
Character of Well (completed as Oil, Gas or Dry Hole) Dry Hole
Date well completed 8-29 1965
Application for plugging filed 11-5 19 65
Application for plugging approved 11-8 19 65
Plugging commenced 11-8 19 65
Plugging completed 11-9 19 65
Reason for abandonment of well or producing formation Dry Hole

If a producing well is abandoned, date of last production None 19
Was permission obtained from the Conservation Division or its agents before plugging was commenced? Yes

Name of Conservation Agent who supervised plugging of this well Mr. Hugh Scott, Sublette, Kansas
Producing formation None Depth to top - Bottom - Total Depth of Well 5750 Feet
Show depth and thickness of all water, oil and gas formations.

OIL, GAS OR WATER RECORDS

CASING RECORD

FORMATION	CONTENT	FROM	TO	SIZE	PUT IN	PULLED OUT
	Water	5700	TD	8-5/8"	1520	N O N E
				2-7/8"	5780	5008

Describe in detail the manner in which the well was plugged, indicating where the mud fluid was placed and the method or methods used in introducing it into the hole. If cement or other plugs were used, state the character of same and depth placed, from 5100 feet to surface feet for each plug set.

Set 35 sack plug at 700'
Set 15 sack plug at 45' to surface
Set Bridge Plug at 5100' with 2 sacks cement
Cut 2-7/8" csg. at 5008'
Pulled 2-7/8" csg. and loaded hole with drilling mud.
Welded on cap 3' below G.I.

RECEIVED
STATE CORPORATION COMMISSION

NOV 17 1965
11-17-65
CONSERVATION DIVISION
Wichita, Kansas

(If additional description is necessary, use BACK of this sheet)

Name of Plugging Contractor Halliburton
Address Liberal, Kansas

STATE OF Texas, COUNTY OF Hansford, ss.
Everett R. Tracy (employee of owner) or (owner or operator) of the above-described well, being first duly sworn on oath, says: That I have knowledge of the facts, statements, and matters herein contained and the log of the above-described well as filed and that the same are true and correct. So help me God.

(Signature) *Everett R. Tracy*
P.O. Box 7, Spearman, Texas 79081 (Address)

SUBSCRIBED AND SWORN to before me this 15 day of November, 1965

My commission expires June 1, 1967
Hansford County, Texas Notary Public.