


15-119-00103-00-00

See

STATE OF KANSAS
STATE CORPORATION COMMISSION
Give All Information Completely
Make Required Affidavit
Mail or Deliver Report to:
Conservation Division
State Corporation Commission
211 No. Broadway
Wichita, Kansas

WELL PLUGGING RECORD

NORTH

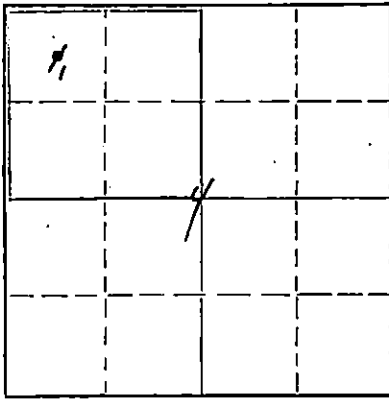

Locate well correctly on above Section Plat

Meade County, Sec. 4 Twp. 32S Rge. (E) 28 (W)
Location as "NE/CNW/SW" or footage from lines C NW/4 NW/4
Lease Owner Skelly Oil Company
Lease Name John Meyer Well No. 1
Office Address Box 1650, Tulsa, Oklahoma
Character of Well (completed as Oil, Gas or Dry Hole) Dry Hole
Date well completed July 8, 19 59
Application for plugging filed July 8, 19 59
Application for plugging approved July 9, 19 59
Plugging commenced July 8, 19 59
Plugging completed July 8, 19 59
Reason for abandonment of well or producing formation Dry Hole

If a producing well is abandoned, date of last production 19
Was permission obtained from the Conservation Division or its agents before plugging was commenced? Yes (verbally)

Name of Conservation Agent who supervised plugging of this well Mr. M. A. Rives
Producing formation None Depth to top Bottom Total Depth of Well 5620 Feet
Show depth and thickness of all water, oil and gas formations.

OIL, GAS OR WATER RECORDS

CASING RECORD

FORMATION	CONTENT	FROM	TO	OD SIZE	PUT IN	PULLED OUT
Chester	Dry	5461'		8-5/8"	1399' 3"	None

Describe in detail the manner in which the well was plugged, indicating where the mud fluid was placed and the method or methods used in introducing it into the hole. If cement or other plugs were used, state the character of same and depth placed, from feet to feet for each plug set.

50 sacks of cement	5620' to 5558'
Heavy mud	5558' to 600'
Halliburton plug	600'
35 sacks of cement	600' to 495'
Heavy mud	495' to 30'
Halliburton rubber plug	30'
20 sacks of cement	30' to 6'
Surface soil	6' to 0'

RECEIVED
STATE CORPORATION COMMISSION
7-22-59
JUL 22 1959

CONSERVATION DIVISION
Wichita, Kansas

(If additional description is necessary, use BACK of this sheet)
Name of Plugging Contractor Claude Wentworth Drilling Co., Inc.
Address 2701 East 15th, Tulsa, Okla.

STATE OF Kansas, COUNTY OF Reno, ss.
H. E. Wamsley (employee of owner) or (owner or operator) of the above-described well, being first duly sworn on oath, says: That I have knowledge of the facts, statements, and matters herein contained and the log of the above-described well as filed and that the same are true and correct. So help me God.

(Signature) [Signature]
Box 391, Hutchinson, Kansas (Address)

SUBSCRIBED AND SWORN TO before me this 21st day of July, 19 59

My commission expires April 7, 1963

[Signature] Notary Public.

PLUGGING
FILE SEC 4 T. 32 R. 28
BOOK PAGE 49 LINE 36