


15-119-10082-00-00

STATE OF KANSAS
STATE CORPORATION COMMISSION

Give All Information Completely
Make Required Affidavit
Mail or Deliver Report to:
Conservation Division
State Corporation Commission
211 No. Broadway
Wichita, Kansas

WELL PLUGGING RECORD

NORTH

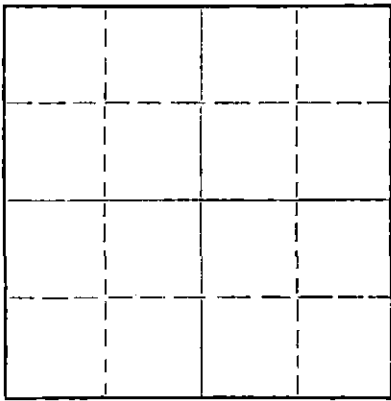

Locate well correctly on above
Section Plat

MEADE

County. Sec. 7 Twp. 32S Rge. 28W ~~28~~ (W)

Location as "NE/CNW/SW" or footage from lines C SW/4
Lease Owner Graham-Michaelis Drilling Co.
Lease Name SANDERS "B" #1 Well No. 1
Office Address 211 North Broadway, Wichita, Ks.
Character of Well (completed as Oil, Gas or Dry Hole) Dry Hole
Date well completed 12-6-57 19
Application for plugging filed 12-6-57 19
Application for plugging approved 12-7-57 19
Plugging commenced 12-7-57 19
Plugging completed 12-7-57 19
Reason for abandonment of well or producing formation Dry Hole

If a producing well is abandoned, date of last production 19
Was permission obtained from the Conservation Division or its agents before plugging was commenced? yes

Name of Conservation Agent who supervised plugging of this well Don Peterson, Box 52, Lakin, Kansas
Producing formation _____ Depth to top _____ Bottom _____ Total Depth of Well 5660 Feet
Show depth and thickness of all water, oil and gas formations.

OIL, GAS OR WATER RECORDS

CASING RECORD

FORMATION	CONTENT	FROM	TO	SIZE	PUT IN	PULLED OUT
<u>Sand, Clay, Shale,</u> <u>Anhy., Red bed.</u>		<u>0</u>	<u>1465*</u>	<u>8 5/8"</u>	<u>1465*</u>	<u>0</u>

Describe in detail the manner in which the well was plugged, indicating where the mud fluid was placed and the method or methods used in introducing it into the hole. If cement or other plugs were used, state the character of same and depth placed, from _____ feet to _____ feet for each plug set.

Plugged hole. Bottom plug @1250* W/6 sacks cement. Middle plug @550* W/9 sacks cement. Top plug @25* W/5 sacks cement. Plug down @4:00 A. M.

RECEIVED
STATE CORPORATION COMMISSION
12-19-57
DEC 19 1957

CONSERVATION DIVISION
Wichita, Kansas

(If additional description is necessary, use BACK of this sheet)

Name of Plugging Contractor Graham-Michaelis Drilling Company
Address 211 North Broadway, Wichita, Kansas

STATE OF KANSAS, COUNTY OF SEDGWICK, ss.
O. W. Woodland (employee of owner ~~or representative~~) of the above-described well, being first duly sworn on oath, says: That I have knowledge of the facts, statements, and matters herein contained and the log of the above-described well as filed and that the same are true and correct. So help me God. Graham-Michaelis Drilling Co.

(Signature) [Signature]
211 No. Broadway, Wichita, Ks.
(Address)

SUBSCRIBED AND SWORN TO before me this 13th day of December, 19 57

[Signature]
Notary Public.

My commission expires 1/7/61

PLUGGING
FILE SEC 7 T 32 R 28W
BOOK PAGE 68 LINE 21

