

15-119-20138-00-00

STATE OF KANSAS  
STATE CORPORATION COMMISSION

Form CP-4

WELL PLUGGING RECORD

Give All Information Completely  
State Required Affidavit  
Mail or Deliver Report to:  
Conservation Division  
State Corporation Commission

P. O. BOX 17027  
Wichita, Kansas 67217  
NORTH

Meade County, Sec. 14, Twp. 32S, Rge. 28W XEX (W)

Location as "NE/CNWSW" or footage from lines C NW-NW

Lease Owner Sidwell Oil & Gas, Inc.

Lease Name Friesen Well No. 1-14

Office Address PO Box 2475, Pampa, Texas 79065

Character of Well (completed as Oil, Gas or Dry Hole) dry hole

Date well completed August 15 19 74

Application for plugging filed August 15 19 74

Application for plugging approved August 15 19 74


Plugging commenced August 15 19 74

Plugging completed August 15 19 74

Reason for abandonment of well or producing formation

If a producing well is abandoned, date of last production 19

Was permission obtained from the Conservation Division or its agents before plugging was commenced? yes

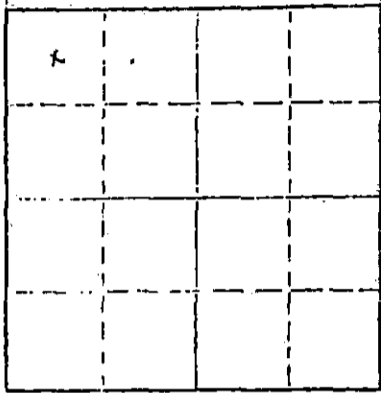

Locate well correctly on above Section Plot

Name of Conservation Agent who supervised plugging of this well

Producing formation Depth to top Bottom Total Depth of Well 5600 Feet

Show depth and thickness of all water, oil and gas formations.

OIL, GAS OR WATER RECORDS

CASING RECORD

| FORMATION | CONTENT | FROM | TO | SIZE   | PUT IN | PULLED OUT |
|-----------|---------|------|----|--------|--------|------------|
|           |         |      |    | 8 5/8" | 764'   |            |
|           |         |      |    |        |        |            |
|           |         |      |    |        |        |            |
Describe in detail the manner in which the well was plugged, indicating where the mud fluid was placed and the method or methods used in introducing it into the hole. If cement or other plugs were used, state the character of same and depth placed, from feet to feet for each plug set.

650'/750' 35 sx.

45'/0' 45 sx.

RECEIVED  
STATE CORPORATION COMMISSION  
AUG 23 1974  
CONSERVATION DIVISION  
Wichita, Kansas

(If additional description is necessary, use BACK of this sheet)

Name of Plugging Contractor Zenith Drilling Corporation, Inc.

Address Suite 600, 200 West Douglas, Wichita, Kansas 67202

STATE OF Kansas COUNTY OF Sedgwick ss.

C. Robert Buford

(owner or operator) of the above-described well, being first duly sworn on oath, says: That I have knowledge of the facts, statements, and matters herein contained and the log of the above-described well as filed and that the same are true and correct. So help me God.

(Signature) C. Robert Buford

200 W. Douglas, Wichita, Kansas (Address)

SUBSCRIBED AND SWORN to before me this 19th day of August, 19 74

My commission expires February 4, 1978

Karen K. Morris Notary Public

15-119-20138-00-00

# WELL LOG

COMPANY Sidwell Oil & Gas, Inc.  
P. O. Box 2475, Pampa, Tex. 79065

SEC. 14-32S-28W

FARM Friesen NO. 1-14

Loc. NW NW


TOTAL DEPTH 5600'

COUNTY Meade County, Kansas

COMM. 8-2-74 COMP. 8-15-74

CONTRACTOR Zenith Drilling Corporation, Inc.  
Suite 600, 200 W. Douglas, Wichita, Ks

CASING  
764' 8 5/8" csg, w/ 525 sx

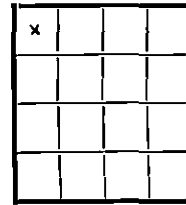

ELEVATION

PRODUCTION

FIGURES INDICATE BOTTOM OF FORMATIONS

- 0 - 75' Clay and Sand
- 75 - 400' Sand
- 400 - 1725' Redbed
- 1725 - 2870' Shale & Lime
- 2870 - 3152' Lime
- 3152 - 3390' Lime & Shale
- 3390 - 3898' Lime
- 3898 - 4430' Lime
- 4430 - 4984' Lime w/sand streak
- 4984 - 5600' Lime T. D.

RECEIVED  
STATE CORPORATION COMMISSION  
AUG 23 1974  
CONSERVATION DIVISION  
Wichita, Kansas

State of Kansas }  
County of Sedgwick } ss

I, C. Robert Buford, President of Zenith Drilling Corporation, Inc.  
upon oath state the above and foregoing is a true and correct copy of the log of the Friesen #1-14 well.

C. Robert Buford  
C. Robert Buford

Subscribed and sworn to before me this 19th day of August, 1974

My Commission Expires: February 4, 1978

Karen K. Morris

NOTARY PUBLIC

Karen K. Morris