

STATE OF KANSAS
STATE CORPORATION COMMISSION

WELL PLUGGING RECORD

Give All Information Completely
Make Required Affidavit
Mail or Deliver Report to
Conservation Division
State Corporation Comm.
245 North Water
Wichita, KS 67202

Meade County, Sec. 18 Twp. 32S Rge. 28 E/W
Location as "NE/CNW 1/4 SW 1/4" or footage from lines
C SW SW


Lease Owner Mesa Petroleum
Lease Name Sanders Well No. 1-18
Office Address P.O. Box 1578, Liberal, Kansas
Character of Well (Completed as Oil, Gas or Dry Hole)
Dry Hole

Date Well completed 5-15 19 78
Application for plugging filed 19
Application for plugging approved 5-14 (verbal) 19 78
Plugging commenced 5-14 19 78
Plugging completed 5-15 1978
Reason for abandonment of well or producing formation
Dry Hole

If a producing well is abandoned, date of last production
19

Was permission obtained from the Conservation Division or
its agents before plugging was commenced? Yes

Name of Conservation Agent who supervised plugging of this well Clarence Thomas, Jr.
Producing formation Depth to top Bottom Total Depth of Well 5905
Show depth and thickness of all water, oil and gas formations.

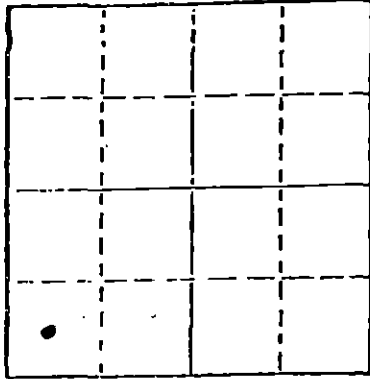

Locate well correctly on above
Section Plat

OIL, GAS OR WATER RECORDS

CASING RECORD

FORMATION	CONTENT	FROM	TO	SIZE	PUT IN	PULLED OUT
				9 5/8	1482	None

Describe in detail the manner in which the well was plugged, indicating where the mud fluid
was placed and the method or methods used in introducing it into the hold. If cement or other
plugs were used, state the character of same and depth placed, from feet to
feet for each plug set.

Plugged well as follows: 60 sacks @ 1400'
15 sacks 40-0'
5 sacks each in mouse & rat holes

(If additional description is necessary, use BACK of this sheet)

Name of Plugging Contractor Halliburton, Liberal, Ks.

STATE OF Kansas COUNTY OF Seward, ss.
Ned E. Lowry, Agent (employee of owner) or (owner or operator)
of the above-described well, being first duly sworn on oath, says: That I have knowledge of
the facts, statements, and matters herein contained and the log of the above-described well
as filed and that the same are true and correct. So help me God.

(Signature) Ned E. Lowry
P.O. Box 1578, Liberal, Kansas 67901
(Address)

SUBSCRIBED AND SWORN TO before me this 15th day of May, 1978

Rhenda J. VanMeter
Notary Public.

My commission expires

