

15-119-30096-00-00


STATE OF KANSAS  
STATE CORPORATION COMMISSION

Form CP-4

Give All Information Completely  
Make Required Affidavit  
Mail or Deliver Report to:  
Conservation Division  
State Corporation Commission  
212 No. Market  
Wichita, Kansas

WELL PLUGGING RECORD

NORTH

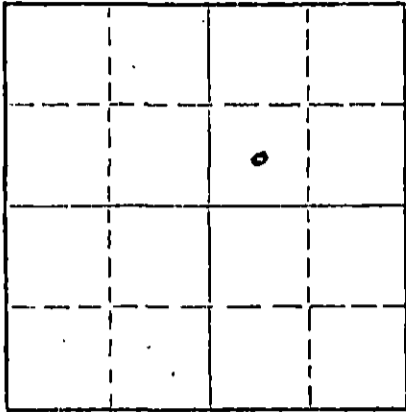

Locate well correctly on above  
Section Plat

Meade County, Sec. 35 Twp. 32S Rge. (E) 28 (W)  
Location as "NE/CNW/SW" or footage from lines SW-NE  
Lease Owner: Shenandoah Oil Corporation  
Lease Name: Henry Loewen Well No. 1  
Office Address: 406 Mutual Savings, Fort Worth, Texas 76102  
Character of Well (completed as Oil, Gas or Dry Hole) Dry Hole  
Date well completed December 11 1966  
Application for plugging filed December 11 1966  
Application for plugging approved December 11 1966  
Plugging commenced 8:30 PM, December 11 1966  
Plugging completed 19  
Reason for abandonment of well or producing formation Non Commercial

If a producing well is abandoned, date of last production - - 19 -  
Was permission obtained from the Conservation Division or its agents before plugging was commenced? Yes

Name of Conservation Agent who supervised plugging of this well Mr. E. Eves, Box E, Sublette, Kansas  
Producing formation None Depth to top - Bottom - Total Depth of Well 5750 Feet  
Show depth and thickness of all water, oil and gas formations.

OIL, GAS OR WATER RECORDS

CASING RECORD

FORMATION	CONTENT	FROM	TO	SIZE	PUT IN	PULLED OUT
Morrow Sand	Show gas	-	-	8-5/8"	1281'	None

Describe in detail the manner in which the well was plugged, indicating where the mud fluid was placed and the method or methods used in introducing it into the hole. If cement or other plugs were used, state the character of same and depth placed, from - feet to - feet for each plug set.

Hole filled with heavy mud from 5750-1273'. Spotted plug, 1 sack hulls and 35 sacks cement @ 1273'. Filled with mud to 40' and spotted plug, 1 sack hulls & 15 sacks cement to surface.

RECEIVED  
STATE CORPORATION COMMISSION

FEB 7 1967  
2-7-67

CONSERVATION DIVISION  
WICHITA, KANSAS

(If additional description is necessary, use BACK of this sheet)

Name of Plugging Contractor Sterling Drilling Company  
Address Sterling, Kansas

STATE OF Texas COUNTY OF Tarrant, ss.

Harold E. Burke (employee of owner) or ~~XXXXXX~~ of the above-described well, being first duly sworn on oath, says: That I have knowledge of the facts, statements, and matters herein contained and the log of the well as described well as filed and that the same are true and correct. So help me God.

(Signature) Harold E. Burke

406 Mutual Savings, Ft. Worth, Texas  
(Address)

Subscribed and sworn to before me this 6th day of February, 1967

My commission expires June 1, 1967

Juanita Brookshire  
Notary Public

15-119-30096-00-00

STERLING DRILLING COMPANY  
Sterling, Kansas

WELL LOG ----- HENRY LOEWEN NO. 1  
LOCATED: SW NE Section 35-32S-28W, Mead County, Kansas

OWNER: Shenandoah Oil Corporation  
ROTARY DRILLING CONTRACTOR: Sterling Drilling Company

COMMENCED: November 20, 1966  
COMPLETED: December 11, 1966

ROTARY TOTAL DEPTH: 5750'

LOG

0 - 50	Sand & Clay
50 - 480	Red Bed & Shale
480 - 1129	Shale & Sand
1129 - 1281	Shale & Anhydrite
1281 - 1780	Shale & Sand
1780 - 2720	Shale & Lime
2720 - 3040	Sand, Chalk & Lime
3040 - 3964	Shale & Lime
3964 - 4005	Lime
4005 - 4890	Shale & Lime
4890 - 4965	Lime
4965 - 5009	Shale & Lime
5009 - 5275	Lime
5275 - 5351	Lime & Shale
5351 - 5609	Lime
5609 - 5676	Lime & Shale
5676 - 5750	Lime T.D.

CASING RECORD

Run 35 joints (1297.46') 8-5/8" O.D.  
2 1/4" casing with guide shoe on bottom,  
set at 1281.86' K.B.. Run Centralizer  
at 1274' and 1168' and centralizer and  
basket at 180', cemented with 450 sacks  
50 - 50 Pozmix with 6% gel, 2% c.c.;  
200 sacks regular with 2% c.c.. Plug  
was down at 2:30 a.m..

RECEIVED  
STATE CORPORATION COMMISSION

FEB 7 1967

CONSERVATION DIVISION  
Wichita, Kansas

Heavy mud to 1275', Halliburton plug  
with 1/4 sack hulls, 35 sacks cement  
through drill pipe. Heavy mud to 40',  
Halliburton plug with 1/4 sack hulls,  
15 sacks cement to surface. 2 sacks  
cement in rathole and 2 sacks cement  
in mousehole. Completed at 8:30 p.m.  
12-11-66.

15-119-30096-00-00

SECTION 35

Township 32 SOUTH

Range 28 WEST

N 89° 51' W - 5281.4'

RECEIVED  
STATE CORPORATION COMMISSION

FEB 7 1967

CONSERVATION DIVISION  
Wichita, Kansas

1980'

1980'

WELL LOCATION

NOTE:-

WELL LOCATION FELL IN  
PASTURE LAND.

RELOCATION PLATS

N 0° 2' W - 5278.7'

N 0° 1' W - 5280'

N 89° 52' W - 5280'

PLAT

NAME: SHENANDOAH OIL CORP'S - LOEWEN NO. 1 -  
WELL LOCATION.

LOCATION C-SW-NE-SECTION 35-T 32S-R 28W-  
MEADE COUNTY KANSAS

Engr: WILLIAM T. SHARP

Box 176

BEAVER, OKLAHOMA

PHONES:- Res. National 5-4791  
Bus. National 5-5311

11-2-66

William T. Sharp  
WILLIAM T. SHARP

R.P.E. No. 1083

Beaver County Engineer