

WELL PLUGGING RECORD

Give All Information Completely  
Make Required Affidavit  
Mail or Deliver Report to:  
Conservation Division  
State Corporation Commission  
211 No. Broadway  
Wichita, Kansas

NORTH


Locate well correctly on above  
Section Plat

Meade County. Sec. 36 Twp. 32 Rge. (E) 28 (W)  
Location as "NE/CNWXSW" or footage from lines C SW SW  
Lease Owner Panhandle Development Co., Inc.  
Lease Name LOEWEN Well No. 1  
Office Address 801 Union Center, Wichita, Kansas.  
Character of Well (completed as Oil, Gas or Dry Hole) Dry Hole  
Date well completed November 8, 19 62  
Application for plugging filed verbally - November 6, 19 62  
Application for plugging approved verbally - November 6, 19 62  
Plugging commenced November 8, 19 62  
Plugging completed November 8, 19 62  
Reason for abandonment of well or producing formation Dry

If a producing well is abandoned, date of last production 19  
Was permission obtained from the Conservation Division or its agents before plugging was commenced? verbally - yes

Name of Conservation Agent who supervised plugging of this well  
Producing formation none Depth to top Bottom Total Depth of Well 5770' Feet  
Show depth and thickness of all water, oil and gas formations.

OIL, GAS OR WATER RECORDS

CASING RECORD

FORMATION	CONTENT	FROM	TO	SIZE	PUT IN	PULLED OUT
				8-5/8"	1243'	None

Describe in detail the manner in which the well was plugged, indicating where the mud fluid was placed and the method or methods used in introducing it into the hole. If cement or other plugs were used, state the character of same and depth placed, from feet to feet for each plug set.  
Filled hole w/heavy mud, to 650'  
Set 1st plug at 650' w/35 sx cement  
Filled hole w/heavy mud to 40'  
Set 2nd plug at 40' w/15 sx cement  
Job completed 3 A. M. 11-8-62

RECEIVED  
STATE CORPORATION COMMISSION  
NOV 30 1962  
11-30-62  
CONSERVATION DIVISION  
Wichita, Kansas

(If additional description is necessary, use BACK of this sheet)

Name of Plugging Contractor McClellan Drilling Company  
Address P. O. Box 1226, Liberal, Kansas

STATE OF Kansas, COUNTY OF Sedgwick, ss.  
I, Lynn Herrington (employee of owner) or (owner or operator) of the above-described well, being first duly sworn on oath, says: That I have knowledge of the facts, statements, and matters herein contained and the log of the above-described well as filed and that the same are true and correct. So help me God.

(Signature) Lynn Herrington  
801 Union Center, Wichita, Kansas  
(Address)

SUBSCRIBED AND SWORN TO before me this 29th day of November, 19 62

My commission expires June 16, 1963  
Notary Public.




STATE OF KANSAS  
STATE CORPORATION COMMISSION

WELL PLUGGING RECORD

*No Change*

Give All Information Completely  
Make Required Affidavit  
Mail or Deliver Report to  
Conservation Division  
State Corporation Comm.  
245 North Water  
Wichita, KS 67202

Meade County, Sec. 36 Twp. 32S Rge. 28 E/W  
Location as "NE/CNW 1/4 SW 1/4" or footage from lines  
661' N & 666' E of SW corner.  
Lease Owner Southwest Gas Storage Company  
Lease Name Loewen Well No. 1  
Office Address P. O. Box 1348, Kansas City, Mo. 64141  
Character of Well (Completed as Oil, Gas or Dry Hole)  
P&A Re-entry 5/12/81  
Date Well completed November 11 19 62  
Application for plugging filed Verbally November 6 19 62  
Application for plugging approved " November 6 19 62  
Plugging commenced November 8 19 62  
Plugging completed November 8 19 62  
Reason for abandonment of well or producing formation

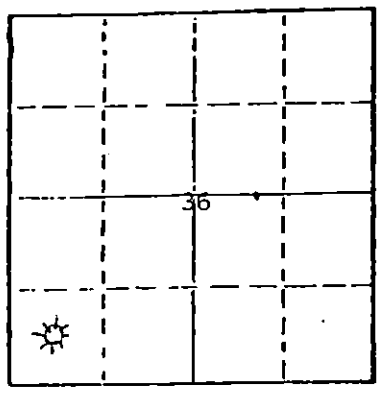

Locate well correctly on above Section Plat

Dry.  
If a producing well is abandoned, date of last production 19  
Was permission obtained from the Conservation Division or its agents before plugging was commenced? Verbally - yes.

Name of Conservation Agent who supervised plugging of this well  
Producing formation None Depth to top - Bottom - Total Depth of Well 5770'  
Show depth and thickness of all water, oil and gas formations.

OIL, GAS OR WATER RECORDS

CASING RECORD

FORMATION	CONTENT	FROM	TO	SIZE	PUT IN	PULLED OUT
NA	Dry			8 5/8"	1243'	0
				2 3/8"	5773'	0

Describe in detail the manner in which the well was plugged, indicating where the mud fluid was placed and the method or methods used in introducing it into the hold. If cement or other plugs were used, state the character of same and depth placed, from feet to feet for each plug set.

Re-entered and cleaned out old plugged and abandoned well to LTD - 5759'. Ran 5773' of used 2 3/8" OD UP tubing and cemented w/50 sx Class H w/5 gallons Morflo followed by 150 sx of Thixotropic.

(If additional description is necessary, use BACK of this sheet)

Name of Plugging Contractor Halliburton

STATE OF Kansas COUNTY OF Meade, ss.  
D. R. Carlile (employee of owner) or (owner or operator)  
of the above-described well, being first duly sworn on oath, says: That I have knowledge of the facts, statements, and matters herein contained and the log of the above-described well as filed and that the same are true and correct. So help me God.

(Signature) *D. R. Carlile*

(Address)

SUBSCRIBED AND SWORN TO before me this 9th day of June, 1982

*Denise H. Ronge*  
Notary Public.

My commission expires 2/27/84

RECEIVED  
STATE CORPORATION COMMISSION

JUN - 9 1982  
6-9-82  
CONSERVATION DIVISION  
Wichita, Kansas

LOEWEN # 1  
 C\*SW\*SW Sec 36-22-38  
 Meade County, Kansas

Commenced - 10-24-62

Completed - 11-8-62

CASING RECORD:

Ran 40 joints of new 24# 8 5/8" surface casing, set @ 1242.87 K. R. Cemented w/ 475 sacks of Pozmix, 2% cc and 150 sacks common, 2% cc - D&A. Plug set at 650' w/35 sacks common and 15 sacks common at 40' to surface.

STATE CORPORATION COMMISSION

NOV 30 1962

FORMATION:

FROM: CONSERVATION DIVISION  
 Wichita, Kansas TO:

Clay and Sand	0	158
Sand and Shale	158	300
Red Bed and Shale	300	570
Red Bed and Sand	570	985
Red Bed and Sand	985	1170
Shale and Shells	1170	1245
Shale	1245	1405
Shale and Shells	1405	1697
Red Bed and Anhydrite	1697	2240
Shale and Lime	2240	2665
Lime	2665	2850
Lime and Shale	2850	2960
Lime	2960	3145
Lime and Shale	3145	3465
Lime	3465	3640
Lime and Shale	3640	3910
Lime	3910	4090
Lime and Shale	4090	4675
Lime	4675	4985
Lime and Shale	4985	5085
Lime	5085	5690
Lime and Shale	5690	5770 RTD

State of Kansas }  
 County of Kansas } SS

I Hereby affirm that the above and foregoing is a true and correct copy of the log of the Loewen No 1 well, located C-SW-SW of section 36-22-38, Meade County, Kansas.

McCLELLAN DRILLING COMPANY, Inc.

by *[Signature]*

Subscribed and sworn to before me a notary public this 9<sup>th</sup> day of November, 1962

*[Signature]*  
 James F. Kyger

My Commission Expires:  
3-31-1965