


15-077-10012-00-01

WELL PLUGGING RECORD

Harper County, Sec. 29 Twp. 31 Rge. ~~XXE~~ 7 (W)

Location as "NE/CNW%SW%" or footage from lines 330' FNL & 310' FWL
 Lease Owner CONOCO
 Lease Name O. J. Tracy Well No. 1
 Office Address 3535 N. W. 58th - Oklahoma City, Oklahoma 73112
 Character of Well (completed as Oil, Gas or Dry Hole) Saltwater Disposal
 Date well completed 10-13 1959
 Application for plugging filed 1-8 1971
 Application for plugging approved 1-8 1971
 Plugging commenced 1-9 1971
 Plugging completed 1-9 1971
 Reason for abandonment of well or producing formation bad casing

NORTH

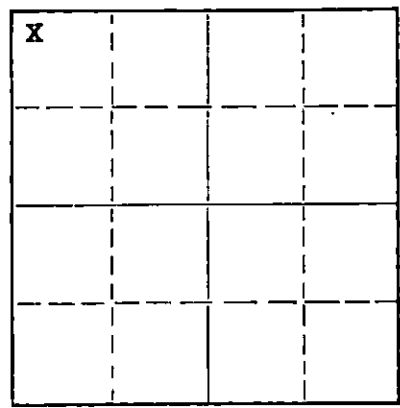

Locate well correctly on above Section Plat

If a producing well is abandoned, date of last production Saltwater Disposal well
 Was permission obtained from the Conservation Division or its agents before plugging was commenced? Yes

Name of Conservation Agent who supervised plugging of this well G. Russell Biberstine
 Producing formation _____ Depth to top _____ Bottom _____ Total Depth of Well 5048 Feet
 Show depth and thickness of all water, oil and gas formations.

OIL, GAS OR WATER RECORDS

CASING RECORD

FORMATION	CONTENT	FROM	TD	SIZE	PUT IN	PULLED OUT
-	-	-	-	8 5/8"	264'	None
				4 1/2"	4884'	Milled out 400'

Describe in detail the manner in which the well was plugged, indicating where the mud fluid was placed and the method or methods used in introducing it into the hole. If cement or other plugs were used, state the character of same and depth placed, from _____ feet to _____ feet for each plug set.
Ran 2 3/8" tubing to 4624'. Halliburton pumped in 25 sacks common cement, filled up to 4299'. Pulled 21 joints. Pumped in 9 sacks Jell. Pulled tubing to 795'. Pumped in 25 sacks common cement, filled up to 470'. Pulled all tubing. Pumped 175 sacks common cement into 8 5/8" surface pipe.

RECEIVED
 STATE CORPORATION COMMISSION
 FEB 11 1971
 CONSERVATION DIVISION
 Wichita, Kansas
 2-11-71

(If additional description is necessary, use BACK of this sheet)

Name of Plugging Contractor Central Drilling Company
 Address Box 907, Great Bend, Kansas

STATE OF Oklahoma, COUNTY OF Oklahoma, ss.
I, Lee R. Shirkey (employee of owner) or (~~owner~~) of the above-described well, being first duly sworn on oath, says: That I have knowledge of the facts, statements, and matters herein contained and the log of the above-described well as filed and that the same are true and correct. So help me God.

(Signature) L. R. Shirkey -Adm. Supr.
3535 N. W. 58th - Oklahoma City, Okla. 73112
 (Address)

SUBSCRIBED AND SWORN TO before me this 8th day of February, 1971

My commission expires Jan. 22, 1973
 My commission expires _____
 Notary Public.



DRILLERS' LOG

Well Owner:	Continental Oil Company	NE NE NW
Farm Name:	Tracy Well No. 1 (Washdown)	Sec. 29-31S-7W
Commenced:	12/30/59	
Completed:	1/12/60	Harper County, Ks.
Total Depth:	5048'	
Casing:	4 1/2" @ 4884' cemented	Elevation:
Contractor:	Peel Brothers, Inc.	Production: SWD

Figures below indicate bottoms of formations:

Washed down old hole	0 -	4740
Sand		4820
Shale & sand		4888
Lime & shale		4935
Lime		5048
Total Depth		5048

This is to certify that the above information is to the best of our knowledge, true and correct.

PEEL BROTHERS, INC.

BY Wendell Peel

SUBSCRIBED AND SWORN to before me this 18th day of January, 1960.

My commission expires: April 27, 1960

S - Notary Public

Kansas Geological Society
DWM
PJL
FILE (2)

RECEIVED
STATE CORPORATION COMMISSION
MAR 23 1960
CONSERVATION DIVISION
Topeka, Kansas