


15-077-10182-00-00

STATE OF KANSAS
STATE CORPORATION COMMISSION

Form CP-4

Give All Information Completely
Make Required Affidavit
Mail or Deliver Report to:
Conservation Division
State Corporation Commission
P. O. Box 17027
Wichita, Kansas 67217
NORTH

WELL PLUGGING RECORD

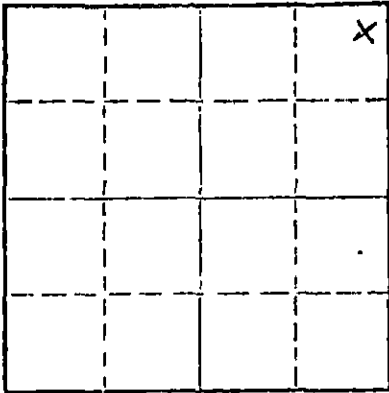

Locate well correctly on above
Section Plot

Harper County, Sec 29 Twp. 31 Rge. 7 (E) W (W)
Location as "NE/CNW/SE/SW" or footage from lines C NE NE NE
Lease Owner Continental Oil Co.
Lease Name L.E. Mathes Well No. # 5
Office Address 3535 N.W. 58th St., Okla. City, Okla.
Character of Well (completed as Oil, Gas or Dry Hole) Oil
Date well completed November 8 19 59
Application for plugging filed October 1973
Application for plugging approved October 1973
Plugging commenced November 6 1973
Plugging completed November 12 1973
Reason for abandonment of well or producing formation Depleted

If a producing well is abandoned, date of last production November 4, 19 73
Was permission obtained from the Conservation Division or its agents before plugging was com-
menced? Yes

Name of Conservation Agent who supervised plugging of this well Russell Riberstein
Producing formation Simpson Depth to top 4666' Bottom 4682' Total Depth of Well 4735 Feet
Show depth and thickness of all water, oil and gas formations.

OIL, GAS OR WATER RECORDS

CASING RECORD

FORMATION	CONTENT	FROM	TO	SIZE	PUT IN	PULLED OUT
Simpson	Oil, Gas & Wtr	4680'	4682'	8 5/8"	263	None
				5 1/2"	4744	2931

Describe in detail the manner in which the well was plugged, indicating where the mud fluid was placed and the method or methods used
in introducing it into the hole. If cement or other plugs were used, state the character of same and depth placed, from _____ feet to
_____ feet for each plug set.

November 6, 1973 Plugged off bottom. Sanded bottom back to
4600'. Mixed and dumped 5 sx of cement.

November 12, 1973 Plugged off top. Set 10' rock bridge at
320'. Filled 8 5/8" surface casing from
320' to base of cellar with 3000 lb. P.S.I.
ready-mix concrete.


RECEIVED
STATE CORPORATION COMMISSION
DEC 26 1973
CONSERVATION DIVISION
Wichita, Kansas
12-26-73

(If additional description is necessary, use BACK of this sheet)
Name of Plugging Contractor RUSS CASING PULLING, INC.
Address P. O. Box 1082 ; Great Bend, Kansas 67530

STATE OF Oklahoma, COUNTY OF Oklahoma
Mr. F. S. Cary (employee of owner) or (owner or operator) of the above-described
well, being first duly sworn on oath, says: That I have knowledge of the facts, statements, and matters herein contained and the log of the
above-described well as filed and that the same are true and correct. So help me God.

(Signature) F. S. Cary Staff Supervisor
3535 NW 58th St., Oklahoma City, Okla. 73112
(Address)

Subscribed AND SWORN to before me this 19th day of December, 1973

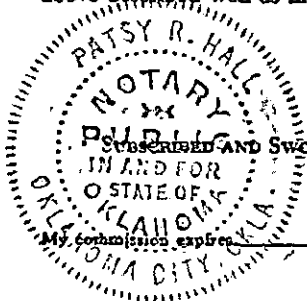

1-10-75

Notary Public.

15-077-10182-00-00

RECEIVED
STATE CORPORATION COMMISSION
JAN 31 1974
CONSERVATION DIVISION
Wichita, Kansas

DRILLERS' LOG

Well Owner: Continental Oil Company
Farm Name: L. E. Mathes Well No. 5
Commenced: 10-15-59
Completed: 11-1-59
Total Depth: 4735'
Casing: 8 5/8" @ 272' w/200 sx
5 1/2" @ 4734' w/250 sx

NE NE NE
Sec. 29, T31S, R7W
Harper County, Kansas

Contractor: Peel Brothers, Inc.

RBE 1512'
RB/GL 9'

Red Bed		
Shale	274	2100
Lime	2100	4515
Lime & Shale	4515	4595
Simpson Dolo.	4595	4690
Simpson Sand	4690	4735
Total Depth		4735
Plug Back Depth		4701