


Give All Information Completely  
Make Required Affidavit  
Mail or Deliver Report to:  
Conservation Division  
State Corporation Commission  
P. O. Box 17027  
Wichita, Kansas 67217  
NORTH

WELL PLUGGING RECORD

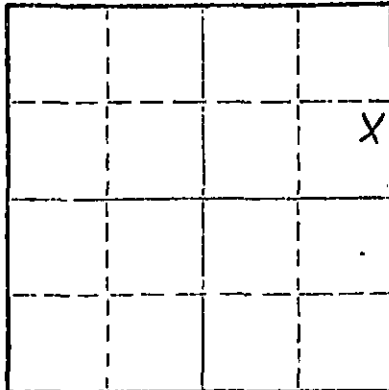

Locate well correctly on above Section Plat

Harper County, Sec. 29 Twp. 31 Rge. 7 (E) W (W)  
Location as "NE/CNWSW" or footage from lines NE SE NE  
Lease Owner Continental Oil Co.  
Lease Name L. E. Mathes Well No. #6  
Office Address 3535 N.W. 58th St. ; Okla. City, Okla.  
Character of Well (completed as Oil, Gas or Dry Hole) Oil  
Date well completed December 8 19 59  
Application for plugging filed October 19 73  
Application for plugging approved October 19 73  
Plugging commenced November 9 19 73  
Plugging completed November 16 19 73  
Reason for abandonment of well or producing formation Depleted

If a producing well is abandoned, date of last production July 12 19 73  
Was permission obtained from the Conservation Division or its agents before plugging was commenced? Yes

Name of Conservation Agent who supervised plugging of this well Russell Biberstein  
Producing formation Simpson Depth to top 4671' Bottom 4687' Total Depth of Well 4726 Feet  
Show depth and thickness of all water, oil and gas formations.

OIL, GAS OR WATER RECORDS

CASING RECORD

FORMATION	CONTENT	FROM	TO	SIZE	PUT IN	PULLED OUT
Simpson	Oil, Gas & Wtr	4673'	4675'	8 5/8"	273	None
				5 1/2"	4733	3578

Describe in detail the manner in which the well was plugged, indicating where the mud fluid was placed and the method or methods used in introducing it into the hole. If cement or other plugs were used, state the character of same and depth placed, from \_\_\_\_\_ feet to \_\_\_\_\_ feet for each plug set.

November 9, 1973 Plugged off bottom. Sanded bottom back to 4600'. Mixed and dumped 5 sx of cement.  
November 16, 1973 Plugged off top. Set 10" rock bridge at 320'. Filled 8 5/8" surface casing from 320' to base of cellar with 3000 lb. P.S.I. ready-mix concrete.


RECEIVED  
STATE CORPORATION COMMISSION  
DEC 26 1973  
12-26-73  
CONSERVATION DIVISION  
Wichita, Kansas

(If additional description is necessary, use BACK of this sheet)  
Name of Plugging Contractor RISS CASING PULLING, INC.  
Address P. O. Box 1082 ; Great Bend, Kansas 67530

STATE OF Oklahoma, COUNTY OF Oklahoma ss.  
Mr. F. S. Cary (employee of owner) or (owner or operator) of the above-described well, being first duly sworn on oath, says: That I have knowledge of the facts, statements, and matters herein contained and the log of the above-described well as filed and that the same are true and correct. So help me God.

(Signature) F. S. Cary Staff Supervisor  
3535 NW 58th St., Oklahoma City, Okla. 73112  
(Address)

Subscribed and sworn to before me this 19th day of December 19 73  
My commission expires 1-10-75

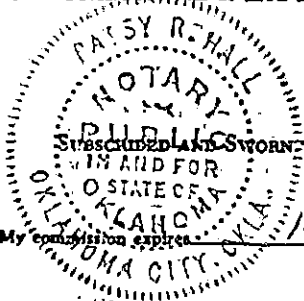

(Signature) Patsy R. Hall  
Notary Public.

15-077-10183-00-00

RECEIVED  
STATE CORPORATION COMMISSION  
JAN 31 1974  
CONSERVATION DIVISION  
Wichita, Kansas

DRILLERS' LOG

Well Owner: Continental Oil Company  
Farm Name: L. E. Mathes Well No. 6  
Commenced: 11-6-59  
Completed: 11-21-59  
Total Depth: 4726'  
Casing: 8 5/8" @ 280 w/200 sx  
5 1/2" @ 4725 w/250 sx

(1650'FNL & 430'FEL)  
NE SE NE  
Sec. 29, T31S, R7W

Harper County, Kansas

Contractor: Peel Brothers, Inc.

RBE 1498'  
RB/GL 9'

Red Bed	0 -	270
Lime	270	1730
Shale	1730	2225
Lime & Shale	2225	4065
Lime	4065	4415
Miss. Lime	4415	4535
Lime	4535	4645
Simpson Dolo.	4645	4726
Total Depth		4726
Plug Back Depth		4689