


WELL PLUGGING RECORD

Give All Information Completely
Make Required Affidavit
Mail or Deliver Report to:
Conservation Division
State Corporation Commission
800 Bitting Building
Wichita, Kansas

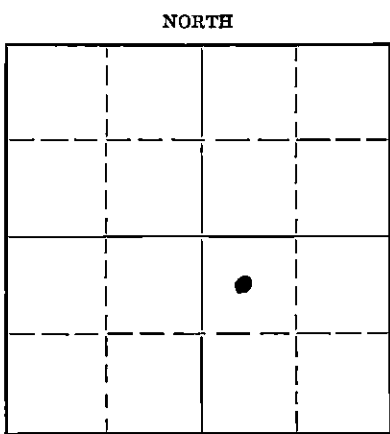

Locate well correctly on above Section Plat

PRATT County. Sec. 10 Twp. 25 Rge. 11 (E) W (W)
Location as "NE/CNW $\frac{1}{4}$ SW $\frac{1}{4}$ " or footage from lines ~~SE $\frac{1}{4}$ -SW $\frac{1}{4}$~~ NE $\frac{1}{4}$
Lease Owner TOKLAN ET AL. SW-NW-SE
Lease Name BUCKLIN Well No. 1
Office Address 1202 NATL. BANK BLDG. - WICHITA KS.
Character of Well (completed as Oil, Gas or Dry Hole) DRY HOLE
Date well completed 4-10-53 1953
Application for plugging filed 4-10 1953
Application for plugging approved 4-10 1953
Plugging commenced 4-10 1953
Plugging completed 4-10 1953
Reason for abandonment of well or producing formation DRY HOLE

If a producing well is abandoned, date of last production 19...
Was permission obtained from the Conservation Division or its agents before plugging was commenced? YES

Name of Conservation Agent who supervised plugging of this well MR. M.A. RIZES - PRATT KS.
Producing formation Depth to top Bottom Total Depth of Well Feet
Show depth and thickness of all water, oil and gas formations.

OIL, GAS OR WATER RECORDS

CASING RECORD

Formation	Content	From	To	Size	Put In	Pulled Out
				8 3/8	162	0

Describe in detail the manner in which the well was plugged, indicating where the mud fluid was placed and the method or methods used in introducing it into the hole. If cement or other plugs were used, state the character of same and depth placed, from... feet to ... feet for each plug set.

CIRC. HEAVY MUD HALF WAY OUT OF HOLE. PUSHED PLUG TO 350' & RUN 30 SACKS CEMENT THROUGH DRILL PIPE - FILLED HOLE WITH MUD TO 40' & PUSHED WOODEN PLUG TO 40' RUN 10 SACKS CEMENT FILLING HOLE TO CELLAR FLOOR

RECEIVED
STATE CORPORATION COMMISSION
APR 21 1953
CONSERVATION DIVISION
Wichita, Kansas
042153

(If additional description is necessary, use BACK of this sheet)
Name of Plugging Contractor SALINA DRILLING CORP.
Address Box 566, SALINA KANS.

STATE OF _____, COUNTY OF _____, SS. _____ (employee of owner) or (owner or operator) of the above-described well, being first duly sworn on oath, says: That I have knowledge of the facts, statements, and matters herein contained and the log of the above-described well as filed and that the same are true and correct. So help me God.

(Signature) Loren J. Hallam
Box 566 Salina, Kansas
(Address)

SUBSCRIBED AND SWORN to before me this 16 day of April, 1953.
George E. Zenger
Notary Public.

My commission expires Oct. 20, 1953 23-8390-s 6-51-20M

PLUGGING
FILE SEC 10 T 28 R 11 W
BOOK PAGE 22 LINE 38

ROTARY DRILLER'S LOG

RIG #2

Bucklin #1
SW/4 NW/4 SE/4
Sec. 10-28-11W
Pratt County, Kansas

Elevation by Laughlin-Simmons
1781 D.F.
1778 R.B.

Casing Record
8 5/8"-162'-125 sacks
cement-circulated.

OPERATOR: TOKLAN PRODUCTION CO.
Kennedy Building
Tulsa 3, Oklahoma

Contractor:
Salina Drilling Corp., Inc.
Box #566, Salina, Kansas.

Well Commenced: 3-20-53

Geologist:
M. E. Wilkinson
519 South Broadway
Wichita, Kansas

Well Completed: 4-10-53

FIGURES INDICATE BOTTOM OF FORMATIONS-K.B.

Rotary Table-Base & Cellar	8	Lime & Shale	3675
Clay & Rock	40	Lime	3705
Sand & Shale	120	Lime & Shale	3772
W.O.C.	235	Lime	3894
Red beds & Sand	780	Lime & Shale	3917
Blue Shale	850	Lime	4039
Shale & Shells	1600	Chert	4070
Sand, limey	1945	Chert & Lime	4992
Lime	2355	Lime & Shale	4198
Lime & Shale	2615	Lime	4215
Shale & Lime	2750	Shale	4246
Lime	2790	Lime & Shale	4260
Lime & Shale	2985	Lime	4313
Lime, sandy	3195	Lime & Shale	4328
Sand	3240	Lime	4360
Lime, sandy	3315	Sand & Shale	4422
Lime	3373	Shale	4455
Shale & Lime	3390	Lime	4505
Shale & Sand	3422	T.D.	4505
Lime, sandy	3501		
Shale & Sand	3546		
Lime	3638		

FORMATION TOPS AS PICKED BY GEOLOGIST-R.B. CORPORATION

Douglas	3452	Kinderhook Dol	4195
Brown lime	3578	Viola	4245
Lansing	3596	Simpson shale	4353
Mississippi	4039	Simpson sand	4363
Kinderhook	4100	Arbuckle	4455

The above rotary driller's log is complete and correct to the best of my knowledge.

SALINA DRILLING CORPORATION, INC.

By Laura J. Hillman
President

PLUGGING
FILE SEC 107 28 NW
BOOK PAGE 92 LINE 38