

STATE OF KANSAS  
STATE CORPORATION COMMISSION


## WELL PLUGGING RECORD

Give All Information Completely  
Make Required Affidavit  
Mail or Deliver Report to:  
Conservation Division  
State Corporation Commission  
800 Bitting Building  
Wichita, Kansas

## FORMATION PLUGGING RECORD

Strike out upper line  
when reporting plug-  
ging off formations.

NORTH

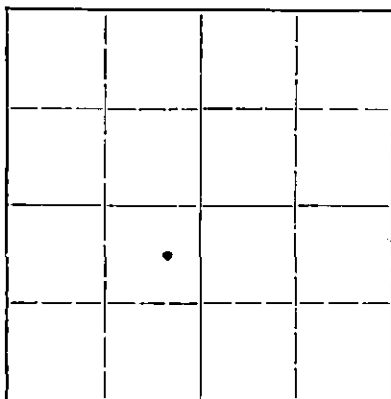

Locate well correctly on above  
Section Plat

Pratt County. Sec. 3 Twp. 28s Rge. 11 (W)  
Location as "NE $\frac{1}{4}$ NW $\frac{1}{4}$ SW $\frac{1}{4}$ " or footage from lines. C-E/2 SE SW  
Lease Owner. Sunray Oil Corporation  
Lease Name. F. H. Sellon Well No. 3  
Office Address. Box 195, Great Bend, Kansas  
Character of Well (completed as Oil, Gas or Dry Hole). Oil  
Date well completed. April 8 1944  
Application for plugging filed. June 11 1948  
Application for plugging approved. Jan. 14 1949  
Plugging commenced. Nov. 7 1949  
Plugging completed. Nov. 18 1949  
Reason for abandonment of well or producing formation. Non-Commercial

If a producing well is abandoned, date of last production. November 4 1949  
Was permission obtained from the Conservation Division or its agents before plugging was com-  
menced? Yes

Name of Conservation Agent who supervised plugging of this well. Ruel Durkee  
Producing formation. ~~Viola C.K.C.~~ Depth to top. 3563 Bottom. 3566 Total Depth of Well. 3566 Feet  
Show depth and thickness of all water, oil and gas formations.

## OIL, GAS OR WATER RECORDS

## CASING RECORD

Formation	Content	From	To	Size	Put In	Pulled Out
Kansas City Lsg.		3533		9"	424'	0
<del>Viola C.K.C.</del> 30' 24"		3563	3566	5 $\frac{1}{2}$ "	3560'	1433'

Describe in detail the manner in which the well was plugged, indicating where the mud fluid was placed and the method or methods used in introducing it into the hold. If cement or other plugs were used, state the character of same and depth placed, from.....feet to  
.....feet for each plug set.

Bottom of hole - 1 yd crushed rock & 10 sax cement. Hole filled w/mud  
200 sax of cement on top. 120 sax of Aqua-gel used in mixing mud.

5 $\frac{1}{2}$ " shot @ 1433

RECEIVED

Conservation Div.

NOV 25 1949

11-25-49

STATE CORPORATION  
COMMISSION  
KANSAS

(If additional description is necessary, use BACK of this sheet)

Correspondence regarding this well should be addressed to. Sunray Oil Corporation  
Address. Box 195, Great Bend, Kansas

STATE OF KANSAS, COUNTY OF BARTON, ss.  
W. R. Yinger (employee of owner) ~~not owner or operator~~ of the above-described well,  
being first duly sworn on oath, says: That I have knowledge of the facts, statements, and matters herein contained and the log of the above-  
described well as filed and that the same are true and correct. So help me God.

(Signature) W. R. Yinger Engineer

Box 195, Great Bend, Kansas  
(Address)

SUBSCRIBED AND SWORN to before me this 23 day of November, 1949

Martha Scott  
Notary Public.

My commission expires April 19, 1952.

21-6858-RS

2-17-CM

PLUGGING  
FILE SEC. 3 T-28-R 110  
BOOK PAGE 121 LINE 26

F. H. SELLON #3

C-E/2 SE SW  
Sec 3-28-11  
Pratt County, Kansas

C  
O  
P  
Y

Sand & clay	70	Shale & lime	2998
Sand & red bed	425	Lime	3030
Red rock & shale	825	Broken Lime	3057
Shale & shells	949	Lime	3301
Shale	1105	Lime & shale	3338
Salt & shale	1230	Shale	3352
Shale	1460	Shale & lime	3458
Lime	1470	Lime & sandy streaks	3502
Lime & shale streaks	1594	Shale	3539
Lime & shale	1772	Top of KC Lime	
Lime	1992	Lime	3568
Shale	2035	Top of Pay 3563'	
Hard lime	2054	Saturated Lime	3572
Shale	2094		
Shale sticky	2153	TOTAL DEPTH	3572'
Lime & shale	2433		
Lime	2493	9" set @ 424' w/50 sx	
Shale	2520	5 1/2" set @ 3560' w/150 sx	
Shale & lime streaks	2584		
Lime & shale	2940		

I, Fred McDaniel, do hereby certify that the above is a true and complete log of Sunray Oil Corporation's F. H. Sellon #3 located C-E/2 SE SW, Sec. 3-28-11, Pratt County, Kansas.

*Fred M. Daniel*  
Ass't. Div. Supt.

June 17, 1948

*Martha Scott*  
Notary Public

My Commission expires: April 19, 1952

