


STATE OF KANSAS  
STATE CORPORATION COMMISSION

WELL PLUGGING RECORD

Give All Information Completely  
Make Required Affidavit  
Mail or Deliver Report to  
Conservation Division  
State Corporation Comm.  
245 North Water  
Wichita, KS 67202

Pratt County, Sec. 26 Twp. 28S Rge. 11 E/W  
Location as "NE/CNW $\frac{1}{4}$ SW $\frac{1}{4}$ " or footage from lines 150' North of  
C NW NW (510' ENL & 660' FWL)  
Lease Owner Hummon Corporation  
Lease Name Dudrey Well No. 1  
Office Address 400 One Main Place, Wichita, KS 67202  
Character of Well (Completed as Oil, Gas or Dry Hole) Dry hole  
Date Well completed 11-21-82 19  
Application for plugging filed 11-21-82 19  
Application for plugging approved 11-21-82 19  
Plugging commenced 11-22-82 19  
Plugging completed 11-22-82 19  
Reason for abandonment of well or producing formation

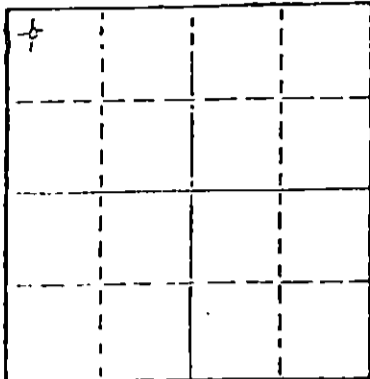

Locate well correctly on above  
Section Plot

If a producing well is abandoned, date of last production 19

Was permission obtained from the Conservation Division or  
its agents before plugging was commenced? Yes

Name of Conservation Agent who supervised plugging of this well Steve Durant @ Belpre, KS  
Producing formation Depth to top Bottom Total Depth of Well 4575'  
Show depth and thickness of all water, oil and gas formations.

OIL, GAS OR WATER RECORDS

CASING RECORD

FORMATION	CONTENT	FROM	TO	SIZE	PUT IN	PULLED OUT
	Surface	0	417	8-5/8"	yes	no

Describe in detail the manner in which the well was plugged, indicating where the mud fluid  
was placed and the method or methods used in introducing it into the hold. If cement or other  
plugs were used, state the character of same and depth placed, from feet to  
feet for each plug set.

50-50 Poz 2% gel: 50 sx @ 840'  
50 sx @ 420'  
10 sx @ 40'  
10 sx in rathole  
10 sx in mousehole  
Job complete @ 6:00 a.m. 11/22/82

(If additional description is necessary, use BACK of this sheet)

Name of Plugging Contractor Big-H Drilling, Inc.

STATE OF KANSAS COUNTY OF SEDGWICK, ss.  
Wilber Berg of Hummon Corporation (employee of owner) or (owner or operator)  
of the above-described well, being first duly sworn on oath, says: That I have knowledge of  
the facts, statements, and matters herein contained and the log of the above-described well  
as filed and that the same are true and correct. So help me God.

(Signature) Wilber Berg  
400 One Main Place, Wichita, KS 67202  
(Address)

SUBSCRIBED AND SWORN TO before me this 29<sup>th</sup> day of November, 1982  
SANDRA L. MENDOZA  
STATE NOTARY PUBLIC  
SEDGWICK COUNTY, KANSAS  
MY APPT. EXP. 2/13/86

Sandra L. Mendoza  
Notary Public.

RECEIVED  
STATE CORPORATION COMMISSION

DEC 1 1982  
CONSERVATION DIVISION  
Wichita, Kansas

DRILLERS LOG

#1 Dudrey

CASING RECORD:	COMPANY:	Hummon Corporation	DESCRIPTION:
8-5/8" @ 417' w/ 350 sx cement	CONTRACTOR:	Big-H Drilling, Inc.	510' FNL & 660' FWL NW/4 Sec. 26-28S-11W Pratt County, Kansas
Plugged & abandoned	COMMENCED:	November 12, 1982	ELEVATION: 1780 KB
	COMPLETED:	November 22, 1982	

<u>FORMATION</u>	<u>FROM</u>	<u>TO</u>	<u>REMARKS</u>
Sand	0	167	
Red Beds	167	417	
Shale & Red Beds	417	425	
Red Beds, Shale & Lime	425	1258	
Lime & Shale	1258	1590	
Shale & Lime	1590	2084	
Lime & Shale	2084	2341	
Shale & Lime	2341	2816	
Lime & Shale	2816	3026	
Shale & Lime	3026	3183	
Lime & Shale	3183	3372	
Shale & Lime	3372	3772	
Lime & SHale	3772	3905	
Shale & Lime	3905	4030	
Lime & SHale	4030	4304	
Shale & Lime	4304	4360	
Lime & Shale	4360	4441	
Shale & Sand	4441	4460	
Sand & Lime	4460	4492	
Lime & Shale	4492	4575	
RTD		4575	


I certify that this is a true and correct copy of the above log to the best of my knowledge.

BIG-H DRILLING, INC.

  
Karen R. Tennis

Subscribed and sworn to before me this 24th day of November, 1982.

SANDRA L. MENDOZA  
NOTARY PUBLIC  
SEDGWICK COUNTY, KANSAS  
MY APPT. EXP. 2/13/86

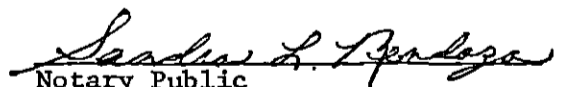  
Notary Public

RECEIVED  
STATE CONSERVATION COMMISSION  
DEC 1 1982  
CONSERVATION DIVISION  
Wichita, Kansas