


15-151-20197-00-00

STATE OF KANSAS  
STATE CORPORATION COMMISSION

Form CP-4

Give All Information Completely  
Make Required Affidavit  
Mail or Deliver Report to:  
Conservation Division  
State Corporation Commission  
P. O. Box 17027  
Wichita, Kansas 67217  
NORTH

WELL PLUGGING RECORD

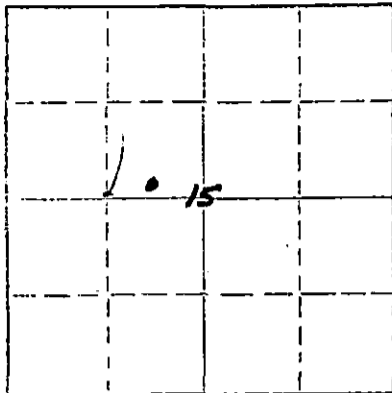

Locate well correctly on above  
Section Plot

Pratt County. Sec. 15 Twp. 28S Rge. 13W (E) (W)  
Location as "NE/CNWSW" or footage from lines C S/2 SE/4 NW/4  
Lease Owner Pratt County Commissioners  
Lease Name #1 Pratt County Well No. 1  
Office Address P. O. Box 338, Kingfisher  
Character of Well (completed as Oil, Gas or Dry Hole) Dry hole  
Date well completed July 20, 1972 19  
Application for plugging filed July 20, 1972 19  
Application for plugging approved July 20, 1972 19  
Plugging commenced July 20, 1972 19  
Plugging completed July 20, 1972 19  
Reason for abandonment of well or producing formation  
Well DST Water in all Zones  
If a producing well is abandoned, date of last production None 19  
Was permission obtained from the Conservation Division or its agents before plugging was commenced? Yes

Name of Conservation Agent who supervised plugging of this well G. Russell Biberstein  
Producing formation None Depth to top \_\_\_\_\_ Bottom \_\_\_\_\_ Total Depth of Well 4578 Feet  
Show depth and thickness of all water, oil and gas formations.

OIL, GAS OR WATER RECORDS

CASING RECORD

FORMATION	CONTENT	FROM	TO	SIZE	PUT IN	PULLED OUT
Surface Pipe		Ground	330'	8 5/8	332'	None
No Production Casing Run						

Describe in detail the manner in which the well was plugged, indicating where the mud fluid was placed and the method or methods used in introducing it into the hole. If cement or other plugs were used, state the character of same and depth placed, from \_\_\_\_\_ feet to \_\_\_\_\_ feet for each plug set.

After DST #2 in the Simpson recovered 250' of water  
Contractor layed down drill pipe & Sun Oilwell Cementing Service  
Set cement plug at 450' of 40 sks  
15 sks set at 40' and 2 sks of cement in rat hole

RECEIVED  
STATE CORPORATION COMMISSION  
SEP 1 1972  
9-1-72  
CONSERVATION DIVISION  
Wichita, Kansas

(If additional description is necessary, use BACK of this sheet)

Name of Plugging Contractor Thomas Drilling Company  
Address Duncan, Oklahoma

STATE OF Oklahoma COUNTY OF Kingfisher, ss.  
Gerald E. Borelli (employee of owner) or (owner or operator) of the above-described well, being first duly sworn on oath, says: That I have knowledge of the facts, statements, and matters herein contained and the log of the above-described well as filed and that the same are true and correct. So help me God.

(Signature)

Gerald E. Borelli  
P. O. Box 338, Kingfisher, Okla  
(Address)

SUBSCRIBED AND SWORN to before me this 20th day of July, 19 72

My commission expires April 26, 1975

Notary Public.