


WELL PLUGGING RECORD

Give All Information Completely
Make Required Affidavit
Mail or Deliver Report to:
Conservation Division
State Corporation Commission
212 No. Market
Wichita, Kansas

NORTH

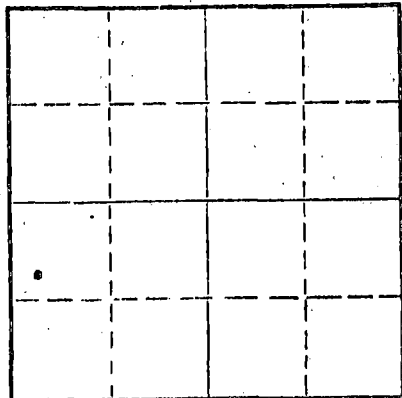

Locate well correctly on above
Section Plat

Meade County, Sec. 21 Twp. 33S Rgs. (E) 30 (W)
Location as "NE/CNW&SW&" or footage from lines SW NW SW
Lease Owner Cotton Petroleum Corporation
Lease Name Gibler "B" Well No. 1
Office Address 2121 S. Columbia Tulsa, Oklahoma
Character of Well (completed as Oil, Gas or Dry Hole) dry
Date well completed March 31, 19 73
Application for plugging filed 4 19 73
Application for plugging approved 413 19 73
Plugging commenced March 31, 19 73
Plugging completed March 31, 19 73
Reason for abandonment of well or producing formation Dry

If a producing well is abandoned, date of last production 19
Was permission obtained from the Conservation Division or its agents before plugging was commenced? yes

Name of Conservation Agent who supervised plugging of this well Edgar Eves
Producing formation _____ Depth to top _____ Bottom _____ Total Depth of Well 5825 Feet
Show depth and thickness of all water, oil and gas formations.

OIL, GAS OR WATER RECORDS

CASING RECORD

FORMATION	CONTENT	FROM	TO	SIZE	PUT IN	PULLED OUT
				8 5/8"	1259'	

Describe in detail the manner in which the well was plugged, indicating where the mud fluid was placed and the method or methods used in introducing it into the hole. If cement or other plugs were used, state the character of same and depth placed, from _____ feet to _____ feet for each plug set.

35 sx. 1000'
15 sx. 45' / 0

RECEIVED
STATE CORPORATION COMMISSION
MAY 4 1973
CONSERVATION DIVISION
Wichita, Kansas

(If additional description is necessary, use BACK of this sheet)

Name of Plugging Contractor Zenith Drilling Corporation, Inc.
Address Suite 600 - 200 W. Douglas Wichita, Kansas 67202

STATE OF KANSAS, COUNTY OF SEDGWICK, ss.
C. Robert Buford (employee of owner) or (owner or operator) of the above-described well, being first duly sworn on oath, says: That I have knowledge of the facts, statements, and matters herein contained and the log of the above-described well as filed and that the same are true and correct. So help me God.

(Signature) C. Robert Buford
ZENITH DRILLING CORP., INC.
Suite 600 - 200 West Douglas, Wichita, Ks.
(Address)

SUBSCRIBED AND SWORN to before me this 9th day of April, 19 73

My commission expires August 15, 1975. *Maryna S. Murphy* Notary Public.

WELL LOG

COMPANY Cotton Petroleum Company

SEC. 21-33S-30W

FARM Gibler "B"

NO. 1

LOC. SW NW SW


TOTAL DEPTH 5825'

COUNTY Meade

COMM. 3-21-73

COMP. 3-30-73

CONTRACTOR Zenith Drilling Corporation, Inc.

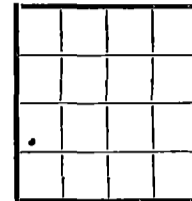

CASING

8 5/8" @ 1259' w/575 sx.

ELEVATION

PRODUCTION

FIGURES INDICATE BOTTOM OF FORMATIONS

- 565' Sand, Clay, Gravel
- 1537' Red Bed
- 2080' Anhydrite, Shale, Shells
- 2475' Red Bed, Lime streaks
- 2855' Lime, Shale
- 3067' Lime, Shale, Dolomite
- 3925' Dolomite
- 5825' Lime, Shale

RECEIVED
 STATE CORPORATION COMMISSION
 MAY 4 1973
 CONSERVATION DIVISION
 Wichita, Kansas

State of Kansas }
 County of Sedgwick } SS

I, C. Robert Buford, President, _____ of Zenith Drilling Corporation, Inc. upon oath state the above and foregoing is a true and correct copy of the log of the Gibler "B" #1 well.

C. Robert Buford

Subscribed and sworn to before me this 9 day of April, 1973.

My Commission Expires: August 15, 1975.

Myrna S. Murphy
 NOTARY PUBLIC