

15-119-10041-0000

STATE OF KANSAS  
STATE CORPORATION COMMISSION


Form CP-4

Give All Information Completely  
Make Required Affidavit  
Mail or Deliver Report to:  
Conservation Division  
State Corporation Commission  
212 No. Market  
Wichita, Kansas 67202

WELL PLUGGING RECORD

Meade County, Sec. 23 Twp. 33S Rge. 30 (W)

Location as "NE/CNW/SW" or footage from lines SW SW SE  
Lease Owner Cities Service Oil Company  
Lease Name Lennen (Novinger Unit) C-4924 Well No. 301  
Office Address Box 1098, Liberal, Kansas 67901  
Character of Well (completed as Oil, Gas or Dry Hole) Oil  
Date well completed April 10 19 52  
Application for plugging filed March 5 19 72  
Application for plugging approved March 6 19 72  
Plugging commenced April 19 19 72  
Plugging completed April 20 19 72  
Reason for abandonment of well or producing formation Depleted

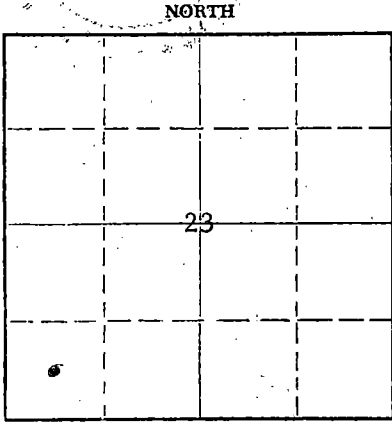

Locate well correctly on above  
Section Plat

If a producing well is abandoned, date of last production January 1970  
Was permission obtained from the Conservation Division or its agents before plugging was commenced? Yes

Name of Conservation Agent who supervised plugging of this well Ed Eves  
Producing formation Marmaton Depth to top 5278 Bottom 5288 Total Depth of Well 5310 Feet  
Show depth and thickness of all water, oil and gas formations.

OIL, GAS OR WATER RECORDS

CASING RECORD

FORMATION	CONTENT	FROM	TO	SIZE	PUT IN	PULLED OUT
Marmaton	Oil	5278	5288	12-3/4	625'	0
				8-5/8	2717'	0
				5-1/2	5308'	2815'

Describe in detail the manner in which the well was plugged, indicating where the mud fluid was placed and the method or methods used in introducing it into the hole. If cement or other plugs were used, state the character of same and depth placed, from \_\_\_\_\_ feet to \_\_\_\_\_ feet for each plug set.

5100' to 5260' 20 sx cement plug  
2025' to 5100' Heavy mud  
1900' to 2025' 40 sx cement plug  
50' to 1900' Heavy mud  
0' to 50' 10 sx cement

RECEIVED  
STATE CORPORATION COMMISSION

APR 26 1972

CONSERVATION DIVISION  
Wichita, Kansas

(If additional description is necessary, use BACK of this sheet)


Name of Plugging Contractor Toland & Johnston  
Address Box 94336, Oklahoma City, Oklahoma 73109

STATE OF KANSAS, COUNTY OF SEWARD, ss.  
R. L. Higginbottom (employee of owner) or (owner or operator) of the above-described well, being first duly sworn on oath, says: That I have knowledge of the facts, statements, and matters herein contained and the log of the above-described well as filed and that the same are true and correct. So help me God.

(Signature)

Box 1098, Liberal, Kansas  
(Address)

SUBSCRIBED AND SWORN TO before me this 24th day of April, 1972

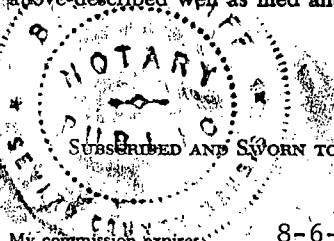

B. J. McGriff Notary Public.

Casing Record

Set 12 3/4" Casing @ 625 With 500 Sacks  
 Set 8 5/8" Casing @ 2717' With 1000 Sacks  
 Set 5 1/2" Casing @ 5308' With 300 Sacks

Commenced: January 31, 1952  
 Completed: March 5, 1952

Surface Clay	0	301
Sand & Shale	301	430
Sand & Redbed	430	660
Redbed & Shale	660	900
Shale	900	1190
Shale & Shells	1190	1495
Shale & Sand	1495	1770
Anhydrite & Shale	1170	1895
Lime & Shale	1895	2255
Shale	2255	2315
Shale & Lime	2315	2376
Lime	2376	2382
Lime & Shale	2382	2392
Lime	2392	2432
Shale & Lime	2432	2460
Lime	2460	2531
Shale & Lime	2531	2559
Lime	2559	2622
Shale & Lime	2622	2639
Cherty & Lime	2639	2652
Lime	2652	2654
Lime & Shale	2654	2702
Lime	2702	2765
Lime & Sand	2765	2819
Lime	2819	3242
Lime & Shale	3242	3312
Lime	3312	3402
Lime & Shale	3402	3498
Lime	3498	3539
Lime & Shale	3539	3570
Shale	2570	3610
Lime & Shale	3610	3648
Lime	2648	3771
Shale	3771	3813
Lime	3813	3901
Lime & Shale	3901	4173
Shale	4173	4190
Shale & Lime	4190	4402
Shale	4402	4431
Shale & Sandy Lime	4431	4537
Lime & Shale	4537	4601
Shale	4601	4619
Lime	4619	4684
Shale & Lime	4684	4734
Lime	4734	4746
Shale	4746	4760
Shale & Lime	4760	4814

Shale & Sandy Lime	4814	4879
Lime	4879	4937
Lime With Shale Streaks	4937	4981
Lime	4981	5091
Shale & Lime	5091	5235
Lime	5235	5307
Total Depth	5307	

RECEIVED  
 STATE CORPORATION COMMISSION  
 MAR 3 1952  
 CONSERVATION DIVISION  
 Wichita, Kansas