

15-119-00157-0000

STATE OF KANSAS
STATE CORPORATION COMMISSION


Give All Information Completely
Make Required Affidavit
Mail or Deliver Report to:
Conservation Division
State Corporation Commission
212 North Market, Insurance Bldg.
Wichita, Kansas

WELL PLUGGING RECORD

Meade County. Sec. 23 Twp. 33 Rge. 30 (E) (W)
Location as "NE/CNW/SW" or footage from lines C/NE/NW

Lease Owner Lanaskan Oil Co.
Lease Name Langhoefer Well No. #7
Office Address 527 Lexington Avenue, New York 17, New York

Character of Well (completed as Oil, Gas or Dry Hole) _____
Date well completed _____ 19____
Application for plugging filed Yes 19____
Application for plugging approved Yes 19____
Plugging commenced _____ 8-12 19 59
Plugging completed _____ 8-19 19 59
Reason for abandonment of well or producing formation DEPLETED

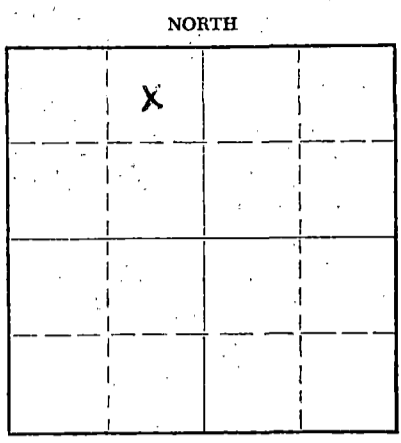

Locate well correctly on above Section Plat

If a producing well is abandoned, date of last production 7-31 19 59
Was permission obtained from the Conservation Division or its agents before plugging was commenced? Yes

Name of Conservation Agent who supervised plugging of this well Mr. Merle Rives
Producing formation _____ Depth to top _____ Bottom _____ Total Depth of Well 5845' Feet
Show depth and thickness of all water, oil and gas formations.

OIL, GAS OR WATER RECORDS

CASING RECORD

FORMATION	CONTENT	FROM	TO	SIZE	PUT IN	PULLED OUT
				5 1/2" casing		3,328'

Describe in detail the manner in which the well was plugged, indicating where the mud fluid was placed and the method or methods used in introducing it into the hole. If cement or other plugs were used, state the character of same and depth placed, from _____ feet to _____ feet for each plug set.

Measured into T.D. 5845'. (PBD)
Plugging started 8-12-59. Finished 8-19-59.
Plugged off bottom and sanded back to 5750'. Dumped 5 sacks of cement. Worked and shot pipe. Shot 5 1/2" casing at 3,328'. Mixed and circulated 50 sacks of mud. Plugged well as follows: Mudded to 550'. Set rock bridge and dumped 20 sacks of cement. Filled hole with mud to 35'. Set rock bridge and capped well with 10 sacks of cement. Well completd.

RECEIVED
STATE CORPORATION COMMISSION
SEP 3 1959
CONSERVATION DIVISION
Wichita, Kansas

(If additional description is necessary, use BACK of this sheet)
Name of Plugging Contractor J.O. Forbes d/b/a Forbes Casing Pulling Co.
Address Box 221, Great Bend, Kansas

STATE OF Kansas, COUNTY OF Barton, ss.
J.O. Forbes (employee of owner) or (owner or operator) of the above-described well, being first duly sworn on oath, says: That I have knowledge of the facts, statements, and matters herein contained and the log of the above-described well as filed and that the same are true and correct. So help me God.

(Signature) J.O. Forbes
Box 221, Great Bend, Kans
(Address)

SUBSCRIBED AND SWORN TO before me this 27th day of August, 19 59
Letty S. Edman
Notary Public.

My commission expires November 8, 1960

PLUGGING
FILE SEC 23 33 R30 W
BOOK PAGE 60 LINE 8

WELL LOG

LANSEKAN LANGHOFER #7

0 - 500	Sand, Shale and Shells
600 - 615	Clay
615 - 678	Red Bed
678 - 995	Red Bed, Shale and Shell
995 - 1910	Shale and Streaks Lime
1910 - 2110	Shale and Fine Shells
2110 - 2350	Shale and Lime
2350 - 2740	Lime
2740 - 4125	Lime
4125 - 4199	Shale and Broken Lime
4199 - 4240	Lime
4240 - 4475	Lime and Shale
4475 - 4736	Lime
4736 - 4753	Shale and Lime
4753 - 5525	Lime
5525 - 5570	Lime and Shale
5570 - 5832	Lime
5832 - 5864	Shale and Lime

PLUGGING
 FILE SEC. 231.33 R 304
 BOOK PAGE 60 LINE 8

RECEIVED
 STATE CORPORATION COMMISSION

AUG 14 1959

CONSERVATION DIVISION
 Wichita, Kansas