


STATE OF KANSAS
STATE CORPORATION COMMISSION

Give All Information Completely
Make Required Affidavit
Mail or Deliver Report to:
Conservation Division
State Corporation Commission
212 No. Market
Wichita, Kansas

WELL PLUGGING RECORD

NORTH

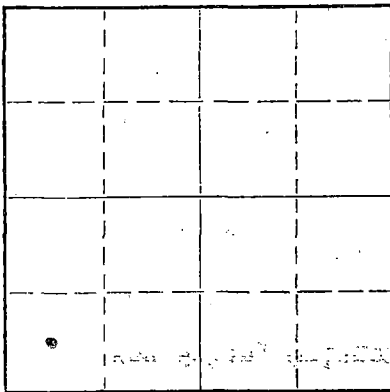

Locate well correctly on above
Section Plat

Meade County, Sec. 23 Twp. 33S Rge. 30 (W)

Location as "NE/CNW/SW" or footage from lines C SW SW

Lease Owner Cities Service Oil Company

Lease Name Lansekan Langhofer (Novinger Unit) #C-4924 Well No. 202

Office Address P. O. Box 1098, Liberal, Kansas 67901

Character of Well (completed as Oil, Gas or Dry Hole) Oil

Date well completed October 24 1951

Application for plugging filed March 5 1972

Application for plugging approved March 6 1972

Plugging commenced March 23 1972

Plugging completed April 3 1972

Reason for abandonment of well or producing formation Well Depleted Oil

If a producing well is abandoned, date of last production November 1966

Was permission obtained from the Conservation Division or its agents before plugging was commenced? Yes

Name of Conservation Agent who supervised plugging of this well Ed Eves

Producing formation Marmaton Depth to top 5254 Bottom 5279 Total Depth of Well 5293 Feet

Show depth and thickness of all water, oil and gas formations.

OIL, GAS OR WATER RECORDS

CASING RECORD

FORMATION	CONTENT	FROM	TO	SIZE	PUT IN	PULLED OUT
Marmaton	Oil	5254	5279	13-3/8	695'	0
				9-5/8	2709'	0
				5-1/2	5329'	3027

Describe in detail the manner in which the well was plugged, indicating where the mud fluid was placed and the method or methods used in introducing it into the hole. If cement or other plugs were used, state the character of same and depth placed, from _____ feet to _____ feet for each plug set.

4200' - 4265' 20 sx cement plug
 2111' - 4200' Heavy mud
 2001' - 2111' 45 sx cement plug
 40' - 2001' Heavy mud
 0' - 40' 10 sx cement plug

RECEIVED
STATE CORPORATION COMMISSION
APR 6 - 1972
CONSERVATION DIVISION
Wichita, Kansas

(If additional description is necessary, use BACK of this sheet)
Name of Plugging Contractor Toland and Johnston
Address Box 94336, Oklahoma 73109

STATE OF KANSAS, COUNTY OF SEWARD, ss.
R. L. Higginbottom (employee of owner) or (owner or operator) of the above-described well, being first duly sworn on oath, says: That I have knowledge of the facts, statements, and matters herein contained and the log of the above-described well as filed and that the same are true and correct. So help me God.

(Signature) *R. L. Higginbottom*
Box 1098, Liberal, Kansas (Address)

SUBSCRIBED AND SWORN TO before me this 4th day of April, 1972

My commission expires 8-6-74 B. J. McGriff Notary Public.

LANGHOFER WELL NO. 2
 SW/4 of SECTION 23, T 33S, R 30W
 MEADE COUNTY, KANSAS

LANGHEAN COMPANY INC,
 714 WEST OLYMPIA BLVD.
 LOS ANGELES 15, CALIF.

RECEIVED
 STATE CORPORATION COMMISSION
 MAR 3 1972
 CONSERVATION DIVISION
 Wichita, Kansas

FORMATION RECORD

	FROM	TO
Sand and shale	0	490
Shale	490	615
Red Bed	615	1155
Shale and red bed	1155	1735
Shale and anhydrite	1735	1785
Shale	1785	2290
Anhydrite and shale	2290	2386
Lime and chert	2386	2438
Anhydrite and shale	2438	2575
Anhydrite	2575	2630
Shale and anhydrite	2630	2678
Anhydrite	2678	2768
Lime	2768	2850
Shale and lime	2850	3302
Lime	3302	3350
Lime and shale	3350	3768
Lime	3768	3935
Lime and shale	3935	3963
Shale	3963	4000
Lime and shale	4000	4177
Shale	4177	4275
Lime and shale	4275	4310
Shale	4310	4415
Shale and lime	4415	4740
Shale	4740	4772
Lime and shale	4772	4799
Lime	4799	4821
Shale and lime	4821	5201
Lime	5201	5241
Cored lime and shale	5241	5293
TOTAL ROTARY DEPTH		5293