


STATE OF KANSAS
STATE CORPORATION COMMISSION
CONSERVATION DIVISION
P. O. BOX 17027
WICHITA, KANSAS 67217

FORM CP-4

WELL PLUGGING RECORD

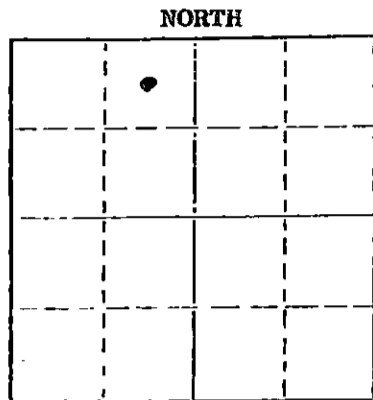

Locate well correctly on above Section Plot

Meade County, Sec. 1 Twp 33S Rge 30 (E) W (W)
Location as "NE/CNW/SW" or footage from lines C NE NW
Lease Owner Gulf Oil Company
Lease Name Edna Collingwood Well No. #3
Office Address 600 Okla. Mortgage Bldg, Okla. City, Okla. 73102
Character of Well (completed as Oil, Gas or Dry Hole) Oil
Date well completed March 27 1957
Application for plugging filed March 17 1975
Application for plugging approved March 19 1975
Plugging commenced 4-17 1975
Plugging completed 4-23 1975
Reason for abandonment of well or producing formation Depleted

If a producing well is abandoned, date of last production December 1974
Was permission obtained from the Conservation Division or its agents before plugging was commenced? yes

Name of Conservation Agent who supervised plugging of this well Clarence Thomas Jr.
Producing formation Morrow Depth to top 5705' Bottom 5730' Total Depth of Well 5862'
Show depth and thickness of all water, oil and gas formations.

OIL, GAS OR WATER RECORDS

CASING RECORD

FORMATION	CONTENT	FROM	TO	SIZE	PUT IN	PULLED OUT
				8 5/8"	1520'	None
				5 1/2"	5862'	2486-54'

Describe in detail the manner in which the well was plugged, indicating where the mud fluid was placed and the method or methods used in introducing it into the hole. If cement or other plugs were used, state the character of same and depth placed, from _____ feet to _____ feet for each plug set.
Shot at 2470', spotted 50 sacks cement, displaced with mud, from 1570' - 1470', spotted 35 sacks cement, displaced with mud, from 950' - 850', capped surface with 10 sacks cement 3' - 33', welded on steel plate.

(If additional description is necessary, use BACK of this sheet)

Name of Plugging Contractor Lillard Casing Pulling, Inc.
Address P.O. Box 962, Woodward, Oklahoma 73801

STATE OF Oklahoma COUNTY OF Oklahoma, ss.
M. T. Farrell, Jr. (employee of owner) or (owner or operator) of the above-described

well, being first duly sworn on oath, says: That I have knowledge of the facts, statements, and matters herein contained and the log of the above-described well as filed and that the same are true and correct. So help me God.

(Signature) M. T. Farrell, Jr.
Gulf Oil Corp., Box 12116, Okla. City, OK 73112
(Address)

SUBSCRIBED AND SWORN TO before me this 8th day of May 1975

My commission expires December 28, 1977

Yvonne M. Feil
Notary Public

RECEIVED
STATE CORPORATION COMMISSION
MAY 9 1975
CONSERVATION DIVISION
Wichita, Kansas

15-119-10089-0000

WELL LOG

COMPANY Gulf Oil Corporation

SEC. 1 T. 33 R. 30W

FARM Edna Collingwood NO. 3

LOC. NE/NW

TOTAL DEPTH 5862'

COMM. 2-26-57

COMP. 3-27-57

COUNTY Meade

KANSAS

SHOT OR TREATED

CONTRACTOR Lewis Drilling Company

ISSUED

CASING

20 10
 15 8 5/8" - 1519.7'
 12 6
 13 5 1/2" - 5862'

ELEVATION 2723 D. F.

PRODUCTION

FIGURES INDICATE BOTTOM OF FORMATIONS


0-70	Clay & Sand	Geologic Tops	
70-110	Sand	Heebner	4411
110-500	Sand & Shale	Lansing KC	4564
500-565	Shale & Red Bed	Base K.C.	4776
565-660	Gravel & Red Bed	Marmaton	5205
660-1165	Red Beds	Cherokee	5349
1165-1520	Red Bed & Anhydrite	Morrow Shale	5677
1520-1740	Red Shale	Morrow Sand	5695
1740-2395	Shale	Mississippian	5762
2395-3195	Lime & Shale		
3195-3265	Lime		
3265-4575	Lime & Shale		
4575-4970	Lime		
4970-5115	Lime & Shale		
5115-5673	Lime		
5673-5700	Shale & Sand		
5700-5730	Sand		
5730-5760	Lime & Shale		
5760-5862	Lime		
5862	Total Depth		

RECEIVED
STATE CORPORATION COMMISSION

MAR 19 1957

CONSERVATION DIVISION
Wichita, Kansas

State of Kansas }
 County of Sedgwick } ss:

I, J. Fred Hambright of the Lewis Drilling Company

upon oath state that the above and foregoing is a true and correct copy of the log of the Edna Collingwood #3 well.

J. Fred Hambright

 J. Fred Hambright

Subscribed and sworn to before me this 30th day of March 19 57

My Commission Expires: 8-20-60

A. R. Derrington

 A. R. Derrington NOTARY PUBLIC