


STATE OF KANSAS
STATE CORPORATION COMMISSION

Give All Information Completely
Make Required Affidavit
Mail or Deliver Report to:
Conservation Division
State Corporation Commission
211 No. Broadway
Wichita, Kansas

WELL PLUGGING RECORD

Meade County, Sec. 1 Twp. 33S Rge. ~~28~~ 30 (W)

Location as "NE/CNW/SW" or footage from lines. C NW NE
Lease Owner. Gulf Oil Corporation
Lease Name E. Collingwood Well No. 5
Office Address Box 661, Tulsa, Oklahoma
Character of Well (completed as Oil, Gas or Dry Hole) Dry Hole
Date well completed 6-2 1957
Application for plugging filed 6-2 1957
Application for plugging approved (verbally by phone) 6-2 1957
Plugging commenced 6-2 1957
Plugging completed 6-2 1957
Reason for abandonment of well or producing formation Dry hole

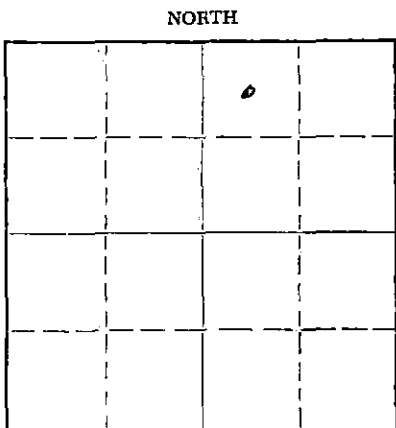

Locate well correctly on above Section Plat

If a producing well is abandoned, date of last production - 19
Was permission obtained from the Conservation Division or its agents before plugging was commenced? Yes

Name of Conservation Agent who supervised plugging of this well M. A. Rives
Producing formation _____ Depth to top _____ Bottom _____ Total Depth of Well 5868 Feet
Show depth and thickness of all water, oil and gas formations.

OIL, GAS OR WATER RECORDS

CASING RECORD

| FORMATION | CONTENT | FROM | TO | SIZE | PUT IN | PULLED OUT |
|-----------|---------|------|----|--------|--------|------------|
| | | | | 8-5/8" | 1536' | - 0 - |
| | | | | | | |
| | | | | | | |
| | | | | | | |
| | | | | | | |
| | | | | | | |
| | | | | | | |
| | | | | | | |
| | | | | | | |

Describe in detail the manner in which the well was plugged, indicating where the mud fluid was placed and the method or methods used in introducing it into the hole. If cement or other plugs were used, state the character of same and depth placed, from _____ feet to _____ feet for each plug set.

Filled with mud to 600'. Placed HOWCO plug and dumped 40 sacks cement. Filled with mud to 40'. Placed HOWCO plug and filled into collar with cement.

NOTE: Attached is Driller's Formation Record which was not available at time application was submitted.

(If additional description is necessary, use BACK of this sheet)

Name of Plugging Contractor Lewis Drilling Company
Address Union Center Building, Wichita, Kansas

STATE OF Kansas, COUNTY OF Sedgwick, ss.
Thomas A. Trax (employee of owner) or (owner or operator) of the above-described well, being first duly sworn on oath, says: That I have knowledge of the facts, statements, and matters herein contained and the log of the above-described well as filed and that the same are true and correct. So help me God.

(Signature) *Thomas A. Trax*
Thomas A. Trax - Asst. Zone Supt. of Prod.
Box 2233, Wichita, Kansas
(Address)

SUBSCRIBED AND SWORN TO before me this 3rd day of June, 1957

Ray W. Rouser
Ray W. Rouser Notary Public.

My commission expires 2-1-59

JRM:BJT

PLUGGING
FILE SEC 1 33 30W
BOOK PAGE 17 LINE 20

RECEIVED
STATE CORPORATION COMMISSION

JUN 12 1957

CONSERVATION DIVISION
KANSAS


WELL LOG

COMPANY **Gulf Oil Corporation**
 FARM **Edna Collingwood** NO. **5**

SEC. **1** T. **33** R. **30W**
 LOC. **C/NW/NE**

TOTAL DEPTH **5868'**
 COMM. **5-6-57** COMP. **6-3-57**
 SHOT OR TREATED
 CONTRACTOR **Lewis Drilling Company**
 ISSUED

COUNTY **Meade**
 KANSAS

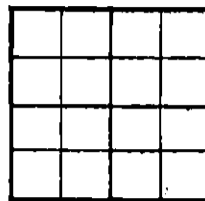

CASING
 20 10
 15 **8 5/8" = 1539'**
 12 6
 13 5

ELEVATION **2728 K.B.**
 PRODUCTION

FIGURES INDICATE BOTTOM OF FORMATIONS

0-375
375-1250
1250-1430
1430-1500
1500-1540
1540-2125
2125-2335
2335-2550
2550-4280
4280-4595
4595-4700
4700-4815
4815-4995
4995-5040
5040-5719
5719-5745
5745-5868
5868

Clay & sand
Red beds
Red beds & Anhydrite
Red beds & Anhydrite
Anhydrite
Shale
Shale & sand
Shale
Shale & lime
Shale
Shale & lime
Lime
Lime & shale
Lime
Lime & shale
Sand & shale
Lime
Total Depth

Geologic Tops

Lansing K.C. 4580
Cherokee 5370
Morrow Shale 5719
Morrow Sand 5753-57
Mississippian 5787
T.D. 5868

State of Kansas }
 County of Sedgewick } ss:

PLUGGING
 FILE SEC. T. 33 30W
 BOOK PAGE 17 LINE 20

I, J. Fred Hambright of the Lewis Drilling Company

upon oath state that the above and foregoing is a true and correct copy of the log of the Edna Collingwood #5 well.

Subscribed and sworn to before me this 10th day of June 19 57
 Kansas

My Commission Expires: 8-20-60

J. Fred Hambright
A. R. Darrington
 NOTARY PUBLIC