


Give All Information Completely
Make Required Affidavit
Mail or Deliver Report to:
Conservation Division
State Corporation Commission
P. O. Box 17027
Wichita, Kansas 67217
NORTH

WELL PLUGGING RECORD

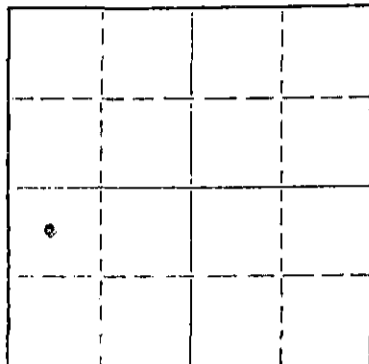

Locate well correctly on above
Section Plot

Meade County, Sec. 2 Twp. 33 Rge. 30 (E) (W) X
Location as "NE/CNW&SW" or footage from lines C NW SW
Lease Owner McAdams Pipe & Supply Co.
Lease Name Holmes Well No. 1
Office Address Drawer 960 Bristow, Oklahoma 74010
Character of Well (completed as Oil, Gas or Dry Hole) Oil
Date well completed August 18 19 55
Application for plugging filed Jan. 29 19 74
Application for plugging approved Jan. 30 19 74
Plugging commenced 5-6 19 74
Plugging completed 5-8 19 74
Reason for abandonment of well or producing formation Depleted
If a producing well is abandoned, date of last production 5-12 19 73
Was permission obtained from the Conservation Division or its agents before plugging was commenced? Yes

Name of Conservation Agent who supervised plugging of this well Ed Eyes
Producing formation Morrow Depth to top 5686 Bottom 5693 Total Depth of Well 5774
Show depth and thickness of all water, oil and gas formations.

OIL, GAS OR WATER RECORDS

CASING RECORD

FORMATION	CONTENT	FROM	TO	SIZE	PUT IN	PULLED OUT
				13 3/8	687	none
				8 5/8	2681	851
				5 1/2	5760	2851

Describe in detail the manner in which the well was plugged, indicating where the mud fluid was placed and the method or methods used in introducing it into the hole. If cement or other plugs were used, state the character of same and depth placed, from _____ feet to _____ feet for each plug set.

Pump 20 sks. of cement to 5550
Pump 50 sks. of cement @ 650 to 550
Put 20 sks. of cement @ 40 to 0

RECEIVED
STATE CORPORATION COMMISSION
MAY 22 1974
CONSERVATION DIVISION
Wichita, Kansas

(If additional description is necessary, use BACK of this sheet)
Name of Plugging Contractor Sargents Casing Pulling Service Kansas No. 511
Address Box 506 Liberal, Kansas 67901

STATE OF OKLAHOMA COUNTY OF CREEK ss.
T. P. McAdams, Jr. (employee of owner) or (owner or operator) of the above-described well, being first duly sworn on oath, says: That I have knowledge of the facts, statements, and matters herein contained and the log of the above-described well as filed and that the same are true and correct. So help me God.

(Signature) [Signature]
P. O. Drawer 960 Bristow, Okla. 74010
(Address)

SUBSCRIBED AND SWORN TO before me this 20th day of May, 19 74

My commission expires September 23, 1975

[Signature]
Notary Public.

WELL LOG BUREAU--KANSAS GEOLOGICAL SOCIETY
503 East Murdock, Wichita, Kansas

COPY


Company: **COLORADO OIL & GAS CORPORATION**
Farm: **Holmes** No. **1**

SEC. **2** T. **33** R. **30W**
C NW SW

Total Depth: **5774**
Comm. **6-13-55**
Shot or Treated.
Contractor.
Issued: **10-8-55**

Comp. **7-22-55**

County **Meade** **KANSAS**

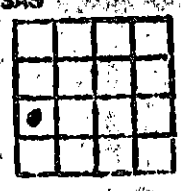

CASING:
13 3/8 687'
8 5/8 2861'
5 1/2 5760'

Elevation: **2727**

Production: **370 BOPD**

Figures indicate Bottom of Formations

clay	100	Lansing	4548
sand	265	Marmaton	5176
sand & shells	665	Cherokee	5327
red rock	709	Atoka	5477
red rock & sand	750	Morrow	5650
red rock & chalky lime	990	Mississippi	5707
red rock & lime	1197		
red rock & sand	1320		
red rock & shells	1500		
anhydrite	1595		
red rock & anhydrite	1675		
red rock & lime	1765		
shale	1865		
shale & lime	2120		
lime	2178		
anhydrite	2195		
shale & anhydrite	2250		
lime & shale	2400		
lime	2570		
shale & lime	2630		
lime	2690		
lime & dolomite	2752		
dolomite	2930		
lime	2963		
shale & lime	3025		
lime	3290		
chalky lime	3302		
lime	3853		
lime & shale	3871		
lime	4158		
lime & shale	4345		
shale	4375		
lime & shale	4525		
lime & chert	4581		
chert	4603		
lime	5119		
lime & shale	5165		
lime	5315		
lime & cherty shale	5352		
lime	5400		
lime & chert	5422		
lime, shale & pyrite streaks	5495		
lime	5667		
coring	5714		
reaming-core hole	5730		
reaming	5734		
coring	5754		
lime	5774		
Total Depth			

RECEIVED
STATE CORPORATION COMMISSION
JAN 30 1974
CONSERVATION DIVISION
Wichita, Kansas

SCOUT TOPS:
Herington 2689
Kridler 2763
Upper Ft. Riley 2867
Lower Ft. Riley 2947
Heebner 4393
Toronto 4453