


STATE OF KANSAS  
STATE CORPORATION COMMISSION

Form CP 1

Give All Information Completely  
Make Required Affidavit  
Mail or Deliver Report to  
Conservation Division  
State Corporation Commission  
P. O. Box 17027  
Wichita, Kansas 67217

WELL PLUGGING RECORD

Meade County, Sec. 2 Twp. 33 Rge. 30 (E) (W) X  
Location as "NE/CNW/SE/SW" or footage from lines C SW NW  
Lease Owner McAdams Pipe & Supply Co.  
Lease Name Holmes Well No. 2  
Office Address Drawer 960 Bristow, Oklahoma 74010  
Character of Well (completed as Oil, Gas or Dry Hole) Oil  
Date well completed March 4 1956  
Application for plugging filed Jan. 29 1974  
Application for plugging approved Jan. 30 1974  
Plugging commenced 4-15 1974  
Plugging completed 4-19 1974  
Reason for abandonment of well or producing formation Abandoned Injection

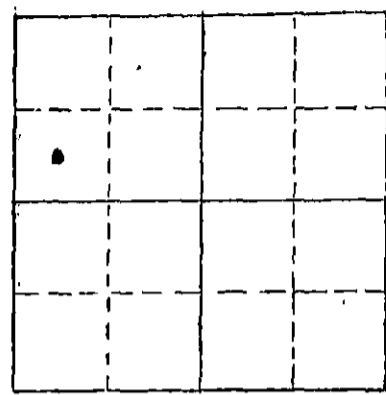

Locate well correctly on above Section Plat

If a producing well is abandoned, date of last production 10  
Was permission obtained from the Conservation Division or its agents before plugging was commenced? Yes

Name of Conservation Agent who supervised plugging of this well Ed Eves  
Producing formation Morrow Depth to top 5671 Bottom 5684 Total Depth of Well 6150 Feet  
Show depth and thickness of all water, oil and gas formations.

OIL, GAS OR WATER RECORDS

CASING RECORD

FORMATION	CONTENT	FROM	TO	SIZE	PUT IN	PULLED OUT
				9 5/8	1583	none
				5 1/2	6139	2851

Describe in detail the manner in which the well was plugged, indicating where the mud fluid was placed and the method or methods used in introducing it into the hole. If cement or other plugs were used, state the character of same and depth placed, from \_\_\_\_\_ feet to \_\_\_\_\_ feet for each plug set.

Pump 20 sks. of cement to 5550  
Pump 35 sks. of cement @ 900 to 800  
Put 15 sks. of cement @ 45 to 0

RECEIVED  
STATE CORPORATION COMMISSION  
MAY 13 1974  
CONSERVATION DIVISION  
Wichita, Kansas

Name of Plugging Contractor Sargents Casing Pulling Service Kansas No. 511  
Address Box 506 Liberal, Kansas 67901

STATE OF OKLAHOMA COUNTY OF CREEK ss.  
T. P. McADAMS, JR.

(employee of owner) or (owner or operator) of the above-described well, being first duly sworn on oath, says: That I have knowledge of the facts, statements, and matters herein contained and the log of the above-described well as filed and that the same are true and correct. So help me God.

(Signature) [Signature] P. O. Drawer 960 - Bristow, Oklahoma 74010 (Address)

Subscribed and Sworn to before me this 10th day of May 1974

[Signature] Notary Public.

My commission expires September 23, 1975

15-119-10014-0000

COPY


WELL LOG BUREAU—KANSAS GEOLOGICAL SOCIETY  
508 East Murdock, Wichita, Kansas

Company- COLORADO OIL & GAS COMPANY  
Farm- Holmes No. 2

SEC. 2 C SW NW 33 R. 30W

Total Depth. 6150  
Comm. 1-11-56 Comp. 2-13-56  
Shot or Treated.  
Contractor.  
Issued. 6-9-56

County Meade KANSAS

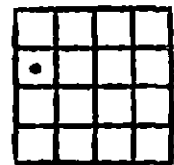

CASING:  
9 5/8" 1583'  
5 1/2" 6139'

Elevation. 2722

Production. 393 bbls

Figures indicate Bottom of Formations.

sand, shells	540
sand, red rock	955
red rock, sand	1275
red rock	1400
red rock, anhydrite	1600
anhyd.	1700
shale, lime	2340
shale, anhyd.	2480
anhyd., lime, shale	2550
lime	2625
lime, anhyd.	2690
anhyd., lime, shale	2740
lime, shale	3030
lime	3086
lime, shale	3155
lime	3225
lime chalky, shale	3585
lime, shale	3655
lime	3825
lime, shale	3886
lime	3945
lime, shale	4060
lime	4150
lime, shale	4215
lime	4250
shale	4290
lime, shale	4563
chert	4589
shale, chalk	4645
lime, shale	4747
lime, chert	4775
chert, lime, shale	4840
chert, lime	4900
chert, lime, shale	4945
lime	4964
shale, lime	5105
lime	5142
lime, chert	5165
chert, lime, shale	5243
shale, lime	5570
chert, lime	5590
lime, shale	5630
chert, lime, shale	5683
Core	5698
sand Morrow, lime, shale	5730
sand, lime, shale	5955
lime	5969
lime, shale	5995
lime	6025
lime, shale	6120
lime	6150
Total Depth	
Tops: Scout	
Lansing	4528
Marmaton	5160
Morrow Sand	5666
Chester	5695
St. Genevieve	5952

RECEIVED  
STATE CORPORATION COMMISSION  
JAN 30 1974  
CONSERVATION DIVISION  
Wichita, Kansas