


STATE OF KANSAS  
STATE CORPORATION COMMISSION

Give All Information Completely  
Make Required Affidavit  
Mail or Deliver Report to:  
Conservation Division  
State Corporation Commission  
800 Bitting Building  
Wichita, Kansas

*TP*  
WELL PLUGGING RECORD

Meade County, Sec. 2 Twp. 33 Rge. (E) 30 (W)

Location as "NE/CNW/SW" or footage from lines C NE SE  
Lease Owner Colorado Oil and Gas Corporation  
Lease Name Holmes Well No. 12  
Office Address P. O. Box 999, Liberal, Kansas  
Character of Well (completed as Oil, Gas or Dry Hole) Dry  
Date well completed 3-5 1957  
Application for plugging filed 5-9 1961  
Application for plugging approved 5-17 1961  
Plugging commenced 6-5 1961  
Plugging completed 6-9 1961  
Reason for abandonment of well or producing formation Dry Hole

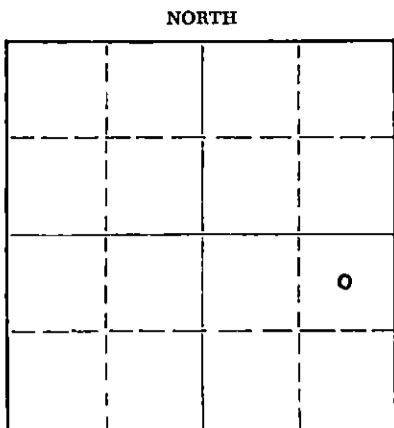

Locate well correctly on above  
Section Flat

If a producing well is abandoned, date of last production None 19      
Was permission obtained from the Conservation Division or its agents before plugging was commenced? Yes

Name of Conservation Agent who supervised plugging of this well W. L. Lackamp Jr.  
Producing formation None Depth to top      Bottom      Total Depth of Well 5870 Feet  
Show depth and thickness of all water, oil and gas formations. PBTD 5824

OIL, GAS OR WATER RECORDS

CASING RECORD

| FORMATION     | CONTENT           | FROM        | TO          | SIZE         | PUT IN      | PULLED OUT     |
|---------------|-------------------|-------------|-------------|--------------|-------------|----------------|
| <u>Morrow</u> | <u>Gas - TSTM</u> | <u>5688</u> | <u>5736</u> | <u>8 5/8</u> | <u>1635</u> | <u>None</u>    |
|               |                   |             |             | <u>5 1/2</u> | <u>5867</u> | <u>2765.96</u> |
|               |                   |             |             |              |             |                |
|               |                   |             |             |              |             |                |
Describe in detail the manner in which the well was plugged, indicating where the mud fluid was placed and the method or methods used in introducing it into the hole. If cement or other plugs were used, state the character of same and depth placed, from      feet to      feet for each plug set.

Filled hole to 5700' with sand. Ran 5 sack cement plug 5700 to 5654. Filled hole with heavy mud to 600'. Set wooden plug with 10' rock bridge on top to 590'. Ran 20 sacks cement to 534'. Mud to 49'. Set rock bridge to 30', ran 10 sacks cement to base of cellar, 5' below ground level.

**RECEIVED**  
STATE CORPORATION COMMISSION  
JUN 19 1961  
CONSERVATION DIVISION  
Wichita, Kansas

(If additional description is necessary, use BACK of this sheet)  
Name of Plugging Contractor Knight Casing Pulling Co.  
Address Chase, Kansas

STATE OF Kansas, COUNTY OF Seward, ss.  
J. A. Ziser (employee of owner) or (owner or operator) of the above-described well, being first duly sworn on oath, says: That I have knowledge of the facts, statements, and matters herein contained and the log of the above-described well as filed and that the same are true and correct. So help me God.

(Signature) J. A. Ziser  
(Address)     

SUBSCRIBED AND SWORN to before me this 16 day of June, 19 61

William B. Claunch  
Notary Public.

My commission expires 11-1-62

