

STATE OF KANSAS  
STATE CORPORATION COMMISSION


Give All Information Completely  
Make Required Affidavit  
Mail or Deliver Report to:  
Conservation Division  
State Corporation Commission

WELL PLUGGING RECORD

P. O. Box 17027  
Wichita, Kansas 67217  
NORTH

Meade County, Sec. 2 Twp. 33S Rge. 30 (E) (W) X

Location as "NE/CNWSW" or footage from lines C SE NW  
Lease Owner McAdams Pipe & Supply Co.  
Lease Name Holmes Well No. 3  
Office Address Drawer 960 Bristow, Oklahoma 74010  
Character of Well (completed as Oil, Gas or Dry Hole) Oil  
Date well completed April 16 1956  
Application for plugging filed Jan. 29 1974  
Application for plugging approved Jan. 31 1974  
Plugging commenced Feb. 8 1974  
Plugging completed Feb. 11 1974  
Reason for abandonment of well or producing formation Depleted

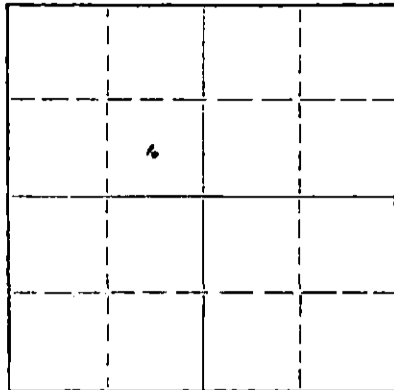

Locate well correctly on above Section Plat

If a producing well is abandoned, date of last production December 1968  
Was permission obtained from the Conservation Division or its agents before plugging was commenced? Yes

Name of Conservation Agent who supervised plugging of this well Ed Eves  
Producing formation Morrow Depth to top 5659 Bottom 5682 Total Depth of Well 5840 Feet  
Show depth and thickness of all water, oil and gas formations.

OIL, GAS OR WATER RECORDS

CASING RECORD

FORMATION	CONTENT	FROM	TO	SIZE	PUT IN	PULLED OUT
				9 5/8	1589	none
				5 1/2	5835	2806

Describe in detail the manner in which the well was plugged, indicating where the mud fluid was placed and the method or methods used in introducing it into the hole. If cement or other plugs were used, state the character of same and depth placed, from feet to feet for each plug set.

Pump 20 sks. of cement @ 5450  
Pump 35 sks. of cement @ 900 to 800  
Put 15 sks. of cement @ 45 to 0

RECEIVED  
STATE CORPORATION COMMISSION

FEB 27 1974

CONSERVATION DIVISION  
Wichita, Kansas

(If additional description is necessary, use BACK of this sheet)

Name of Plugging Contractor Sargents Casing Pulling Service Kansas No. 511  
Address Box 506 Liberal, Kansas 67901

STATE OF OKLAHOMA, COUNTY OF CREEK, ss.  
T. P. McAdams, Jr.

(employee of owner) or (owner or operator) of the above-described well, being first duly sworn on oath, says: That I have knowledge of the facts, statements, and matters herein contained and the log of the above-described well as filed and that the same are true and correct. So help me God.

(Signature)

P. O. Drawer 960, Bristow, Oklahoma 74010  
(Address)

SUBSCRIBED AND SWORN TO before me this 25th day of February, 1974

*Shanda L. West*  
Notary Public.

My commission expires September 23, 1975

15-119-10015-0000

COPY


WELL LOG BUREAU—KANSAS GEOLOGICAL SOCIETY  
508 East Murdock, Wichita, Kansas

Company- COLORADO OIL & GAS  
Farm- Holmes No. 3

SEC. 2 T. 33 R. 30W  
C SE NW

Total Depth. 5850'  
Comm. 3-3-56 Comp. 3-28-56  
Shot or Treated.  
Contractor. Nye & Snell Drlg. Co.  
Issued. 6-9-56

County Meade KANSAS

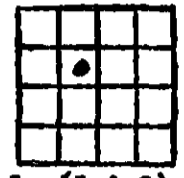

Elevation. 2722 G.L. (L & S)

Production. 3,000 BOFD

Figures indicate Bottom of Formations.

sand-shells	0-140
red bed	1350
shale-shells-anhydrite	1560
anhydrite-red bed-shells-	
shale	1600
shale-shells	1850
red bed-shale	2100
shale-lime	2525
lime	2650
lime-shale	2715
lime	2780
lime-shale	2900
lime	2975
lime-shale	3110
lime	3155
chalky lime	3255
lime-shale	3355
lime	3430
chalky lime	3535
lime-shale	3650
lime	3795
lime-shale	3851
lime	3990
lime-shale	4079
lime	4135
shale-lime	4535
lime	4575
lime-chert	4615
lime-shale	4650
lime-chert	4760
lime-shale	4770
lime	4900
lime-chert	4935
lime-shale	5075
lime	5145
shale-lime	5210
lime	5275
lime-chert	5400
lime-chert-shale	5478
lime	5635
shale-lime	5679
Coring	5697
lime-sand	5705
(Coring 2 hrs. w/core)	
(barrel, ream core hole)	
lime-shale-sand	2756
lime-shale	5825
lime	5850
Total Depth	

TOPS: Scout	
Lansing	4534
Marmaton	5160
Cherokee	5310
Atoka	5458
Morrow shale	5627
Morrow sand	5658
Mississippi	5698

RECEIVED  
STATE CORPORATION COMMISSION  
JAN 30 1974  
CONSERVATION DIVISION  
Wichita, Kansas