

STATE OF KANSAS
STATE CORPORATION COMMISSION


Form CP-1

Give All Information Completely
Make Required Affidavit
Mail or Deliver Report to
Conservation Division
State Corporation Commission

WELL PLUGGING RECORD

P. O. Box 17027
Wichita, Kansas 67217
NORTH

Meade County, Sec 2 Twp 33S Rge 30 (E) (W) X
Location as "NE/CNW4SW4" or footage from lines
Lease Owner McAdams Pipe & Supply Co.
Lease Name Holmes Well No. 7
Office Address Drawer 960 Bristow, Oklahoma 74010
Character of Well (completed as Oil, Gas or Dry Hole) Oil
Date well completed July 16, 1956
Application for plugging filed Jan. 29, 1974
Application for plugging approved Jan. 31, 1974
Plugging commenced Feb. 23, 1974
Plugging completed Feb. 26, 1974
Reason for abandonment of well or producing formation Injection
If a producing well is abandoned, date of last production September 28, 1965
Was permission obtained from the Conservation Division or its agents before plugging was commenced? Yes

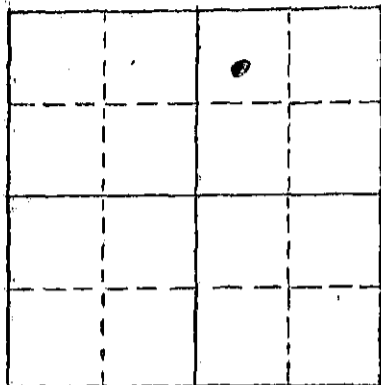

Locate well correctly on above
Section Plat

Name of Conservation Agent who supervised plugging of this well Ed Eves
Producing formation Morrow Depth to top 5649 Bottom 5690 Total Depth of Well 5890 Feet
Show depth and thickness of all water, oil and gas formations.

OIL, GAS OR WATER RECORDS

CASING RECORD

FORMATION	CONTENT	FROM	TO	SIZE	PUT IN	PULLED OUT
				8 5/8	1636	none
				5 1/2	5887	2815

Describe in detail the manner in which the well was plugged, indicating where the mud fluid was placed and the method or methods used in introducing it into the hole. If cement or other plugs were used, state the character of same and depth placed, from _____ feet to _____ feet for each plug set.

Pump 20 sks. of cement @ 5500
Pump 35 sks. of cement @ 1000 to 900
Put 15 sks. of cement @ 45 to 0

RECEIVED
STATE CORPORATION COMMISSION
MAR 20 1974
CONSERVATION DIVISION
Wichita, Kansas

(If additional description is necessary, use BACK of this sheet)
Name of Plugging Contractor Sargents Casing Pulling Service Kansas No. 511
Address Box 506 Liberal, Kansas 67901

STATE OF OKLAHOMA COUNTY OF CREEK ss.
T. P. McAdams, Jr.

(employee or owner) or (owner or operator) of the above-described well, being first duly sworn on oath, says: That I have knowledge of the facts, statements and matters herein contained and the log of the above-described well as filed and that the same are true and correct. So help me God.

(Signature) [Signature]
P. O. Drawer 960, Bristow, Oklahoma 74010
(Address)

Subscribed and sworn to before me this 18th day of March 1974

My commission expires September 23, 1975

Notary Public.

WELL LOG BUREAU—KANSAS GEOLOGICAL SOCIETY
503 East Murdock, Wichita, Kansas


COPY

Company- COLORADO OIL & GAS
Farm- Holmes No. 7

SEC. 2 T. 33 R.30W
CNW NE

Total Depth. 5890' PB 5852'
Comm. 6-20-56 Comp. 7-11-56
Shot or Treated.
Contractor. Nye & Snell
Issued. 9-22-56

County Meade KANSAS

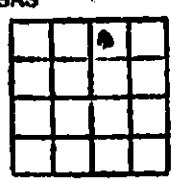

CASING:
8 5/8" 1644' w/750 sx cem.
5 1/2" 5887'

Elevation. 2729' DE

Production. 3,000 bbls.

Figures indicate Bottom of Formations.

sand	250
Base Elaine	715
red rock	1065
sand shale-shells	1495
red rock	1605
red rock-anhydrite	1645
red rock-shale	1885
anhydrite-shale	1935
shale-shells	2260
shale-lime	2955
lime	3015
lime-shale	3115
lime	3167
shale-lime	3419
chalky lime-shale	3830
lime	3905
lime-shale	4065
lime	4110
lime-shale	4840
lime	4905
lime-shale	4935
lime	4970
shale-lime	5105
lime	5134
lime-shale	5265
lime	5305
lime-shale	5365
lime	5395
lime chert	5470
lime-shale	5515
lime-chert-shale	5565
lime-chert	5650
lime	5669
Boring	5698
lime-shale	5890
Total Depth	

TOPS: Scout	
Morrow	5628
Morrow sand	5656

RECEIVED
STATE CORPORATION COMMISSION
JAN 30 1974
CONSERVATION DIVISION
Wichita, Kansas