


STATE OF KANSAS
STATE CORPORATION COMMISSION

Take All Information Completely
Above Required Affidavit
Mail or Deliver Report to
Conservation Division
State Corporation Commission
P. O. BOX 17027
Wichita, Kansas 67217
NORTH

WELL PLUGGING RECORD

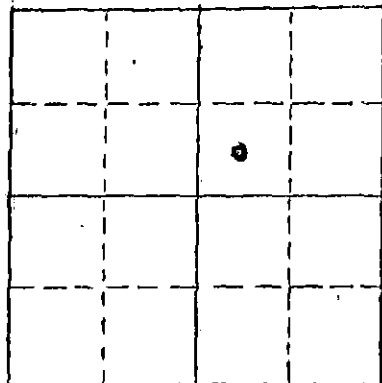

Locate well correctly on above
Section Plat

Location as "NE/CNW/SE/SW" or footage from lines Meade County, Sec. 2 Twp. 33S Rge. 30 (E) (W) X
Lease Owner McAdams Pipe & Supply Co.
Lease Name Holmes Well No. 4
Office Address Drawer 960 Bristow, Oklahoma 74010
Character of Well (completed as Oil, Gas or Dry Hole) Oil
Date well completed May 4 19 56
Application for plugging filed Jan. 29 19 74
Application for plugging approved Jan. 31 19 74
Plugging commenced Feb. 25 19 74
Plugging completed March 1 19 74
Reason for abandonment of well or producing formation Depleted

If a producing well is abandoned, date of last production November 1967
Was permission obtained from the Conservation Division or its agents before plugging was commenced? Yes

Name of Conservation Agent who supervised plugging of this well Ed Eves
Producing formation Morrow Depth to top 5674 Bottom 5702 Total Depth of Well 5840 Feet
Show depth and thickness of all water, oil and gas formations.

OIL, GAS OR WATER RECORDS

CASING RECORD

FORMATION	CONTENT	FROM	TO	SIZE	PUT IN	PULLED OUT
				9 5/8	1609	none
				5 1/2	5824	2810

Describe in detail the manner in which the well was plugged, indicating where the mud fluid was placed and the method or methods used in introducing it into the hole. If cement or other plugs were used, state the character of same and depth placed, from feet to feet for each plug set.

Pump 20 sks. of cement @ 5500
Pump 35 sks. of cement @ 900 to 800
Put 15 sks. of cement @ 45 to 0

RECEIVED
STATE CORPORATION COMMISSION
MAR 20 1974
CONSERVATION DIVISION
Wichita, Kansas

Name of Plugging Contractor Sargents Casing Pulling Service Kansas No. 511
Address Box 506 Liberal, Kansas 67901

STATE OF OKLAHOMA COUNTY OF CREEK
T. P. McAdams, Jr. (Signature)
well, being first duly sworn on oath, says: That I have knowledge of the facts, statements, and matters herein contained and the log of the above-described well as filed and that the same are true and correct. So help me God.
(Signature) [Signature]
P. O. Drawer 960, Bristow, Oklahoma 74010
(Address)

Subscribed and sworn to before me this 18th day of March, 19 74

My commission expires September 23, 1975
Notary Public.


WELL LOG BUREAU—KANSAS GEOLOGICAL SOCIETY
508 East Murdock, Wichita, Kansas

Company- COLORADO OIL & GAS COMPANY
Farm- Holmes No. 4

SEC. 2 T. 33 R. 30W
C SW NE

Total Depth. 5850 PB 5781
Comm. 4-3-56 Comp. 4-29-56
Shot or Treated.
Contractor. Nye & Snell Drilling Co.
Issued. 8-25-56

County Meade
KANSAS

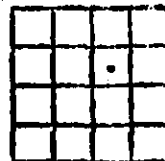

CASING:
8 5/8" 1609'
5 1/2" 5787'

Elevation. 2727

Production. 3000 BOPD

Figures indicate Bottom of Formations.

sand, shells	550
red rock	600
red rock, shells	1010
sand, shells, shale	1355
sand, shells	1541
shale	1555
anhydrite	1625
shale, shells	1740
shale	1980
shale, shells	2412
lime, shale	3810
lime	3855
lime, shale	4580
chert, lime	4620
lime chalky, shells	4675
chert, lime, shale	4727
lime, shale	4858
lime, chert	4930
lime, shale, chert	4940
lime, shale	4975
lime chalky	5070
lime, shale	5170
lime	5202
lime, shale	5240
lime	5305
lime, shale	5336
lime	5435
lime, shale	5470
lime	5595
lime, chert	5650
chert, lime, shale	5689
Coring #1	5694
Coring	5707
sand Morrow, lime, shale	5750
lime	5850

Total Depth
Plugged back to 5781

Tops:	
Lansing	4526
Marmaton	5164
Cherokee	5320
Atoka	5468
Morrow	5638
Mississippi	5705

RECEIVED
STATE CORPORATION COMMISSION
JAN 30 1974
CONSERVATION DIVISION
Wichita, Kansas