


STATE OF KANSAS CORPORATION COMMISSION

WELL PLUGGING RECORD

Information Completely
Make Required Affidavit
Mail or Deliver Report to:
Conservation Division
State Corporation Commission
800 Bittig Building
Wichita, Kansas

Meade County, Sec. 2 Twp. 33 Rge. (E) 30 (W)

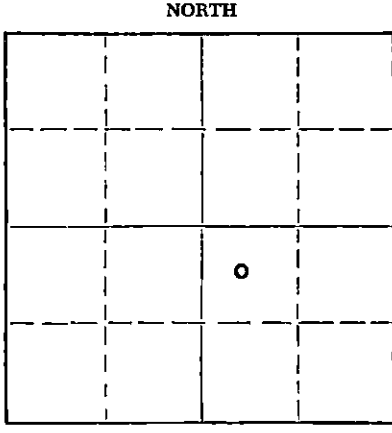

Locate well correctly on above Section Plat

Location as "NE/CNW%SW%" or footage from lines C NW SE
Lease Owner Colorado Oil and Gas Corporation
Lease Name Holmes Well No. 5
Office Address P. O. Box 999, Liberal, Kansas
Character of Well (completed as Oil, Gas or Dry Hole) Dry Hole
Date well completed 7-3 1956
Application for plugging filed 5-9 1961
Application for plugging approved 5-17 1961
Plugging commenced 5-30 1961
Plugging completed 6-3 1961
Reason for abandonment of well or producing formation Dry Hole

If a producing well is abandoned, date of last production None 19
Was permission obtained from the Conservation Division or its agents before plugging was commenced? Yes

Name of Conservation Agent who supervised plugging of this well W. L. Lackamp Jr.
Producing formation None Depth to top Bottom Total Depth of Well Feet
Show depth and thickness of all water, oil and gas formations.

OIL, GAS OR WATER RECORDS

CASING RECORD

| FORMATION | CONTENT | FROM | TO | SIZE | PUT IN | PULLED OUT |
|-----------|----------|------|------|-------|--------|------------|
| Miss. | Dry | 5778 | 5837 | 8 5/8 | 1604 | None |
| Morrow | Show oil | 5740 | 5757 | 5 1/2 | 5870 | 2756.47 |
| | | | | | | |
| | | | | | | |
| | | | | | | |
| | | | | | | |

Describe in detail the manner in which the well was plugged, indicating where the mud fluid was placed and the method or methods used in introducing it into the hole. If cement or other plugs were used, state the character of same and depth placed, from feet to feet for each plug set.

Filled hole to 5650' with sand. Ran 5 sack cement plug 5650' to 5633'. Filled hole with heavy mud to 600'. Set wood plug with 10' rock bridge on top to 590'. Ran 20 sacks cement 590' to 530', heavy mud to 40', set rock bridge 40' to 30', ran 10 sacks cement to base of cellar, 5' below ground level.

RECEIVED
STATE CORPORATION COMMISSION
JUN 17 1961
06-19-61
CONSERVATION DIVISION
Wichita, Kansas

(If additional description is necessary, use BACK of this sheet)
Name of Plugging Contractor Knight Casing Pulling Co.
Address Chase, Kansas

STATE OF Kansas COUNTY OF Seward, ss.
 (employee of owner) or (owner or operator) of the above-described well, being first duly sworn on oath, says: That I have knowledge of the facts, statements, and matters herein contained and the log of the above-described well as filed and that the same are true and correct. So help me God.

(Signature) [Signature]
(Address)

SUBSCRIBED AND SWORN TO before me this 16 day of June, 19 61

My commission expires 11-1-62
William B. Claurick Notary Public.

