


STATE OF KANSAS
STATE CORPORATION COMMISSION

Form CP-1

Give All Information Completely
Make Required Affidavit
Mail or Deliver Report to
Conservation Division
State Corporation Commission
P. O. Box 17027
Wichita, Kansas 67217

WELL PLUGGING RECORD

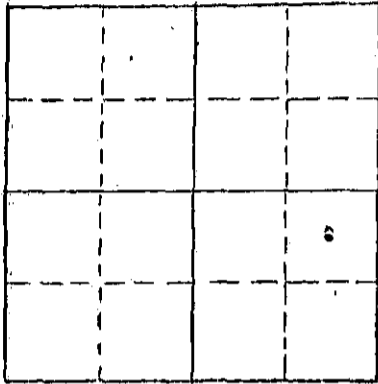

Locate well correctly on above
Section Plat

Meade County, Sec 3 Twp 33 Rge 30 (E) (W) X
Location as "NE/CNWSW" or footage from lines C NE SE
Lease Owner: McAdams Pipe & Supply Co.
Lease Name: Leslie Well No. 4
Office Address: Drawer 960 Bristow, Oklahoma 74010
Character of Well (completed as Oil, Gas or Dry Hole): Oil
Date well completed: May 21 19 56
Application for plugging filed: Jan. 29 19 74
Application for plugging approved: Jan. 30 19 74
Plugging commenced: 4-6 19 74
Plugging completed: 4-12 19 74
Reason for abandonment of well or producing formation:

If a producing well is abandoned, date of last production Injection 10-6 19 70
Was permission obtained from the Conservation Division or its agents before plugging was commenced? Yes

Name of Conservation Agent who supervised plugging of this well Ed Eves
Producing formation Morrow Depth to top 5700 Bottom 5719 Total Depth of Well 5890 Feet
Show depth and thickness of all water, oil and gas formations.

OIL, GAS OR WATER RECORDS

CASING RECORD

FORMATION	CONTENT	FROM	TO	SIZE	PUT IN	PULLED OUT
				8 5/8	1609	none
				5 1/2	5825	3350

Describe in detail the manner in which the well was plugged, indicating where the mud fluid was placed and the method or methods used in introducing it into the hole. If cement or other plugs were used, state the character of same and depth placed, from _____ feet to _____ feet for each plug set.

Pump 20 sks. of cement to 5550
Pump 35 sks. of cement @ 800 to 700
Put 15 sks. of cement @ 45 to 0

RECEIVED
STATE CORPORATION COMMISSION
MAY 7 1974
CONSERVATION DIVISION
Wichita, Kansas

(If additional description is necessary, use BACK of this sheet)
Name of Plugging Contractor: Sargents Casing Pulling Service Kansas No. 511
Address: Box 506 Liberal, Kansas 67901

STATE OF OKLAHOMA

COUNTY OF CREEK ss.

T. P. McAdams, Jr.,
well, being first duly sworn on oath, says: That I have knowledge of the facts, statements, and matters herein contained and the log of the above-described well as filed and that the same are true and correct. So help me God.

(Signature)

P. O. Drawer 960 - Bristow, Oklahoma 74010
(Address)

SUBSCRIBED AND SWORN TO before me this 29th day of April 1974

My commission expires September 23, 1975


Notary Public.

WELL LOG BUREAU - KANSAS GEOLOGICAL SOCIETY
 500 East Murdock, Wichita, Kansas

Company: **COLORADO OIL & GAS CORP. & SUNRAY-MID CONT. SEC.** 3 T. 33 R. 30W
 Farm: **Leslie** No. 4 OIL CO. C NE SE

Total Depth: **5890**
 Comm. **4-17-56** Comp. **5-17-56**
 Shot or Treated.
 Contractor: **Earl F. Wakefield**
 Issued: **7-21-56**

County: **Neade**
KANSAS

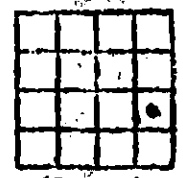

Elevation: **2724 G.L. (L & S)**

Production: **508 BOPD**

CASING:

8 5/8"	1610'
5 1/2"	5890'
clay, sand	270
sand	619
GYP, shells, red bed	884
red bed, gyp	960
red bed	1015
salt, red bed	1230
red bed, sand, shells	1380
red bed, shells	1520
sand	1531
red bed, anhydrite	1595
anhyd.	1640
shale	2040
red bed, anhyd.	2403
anhyd.	2586
anhyd., chert	2633
anhyd.	2828
lime, anhyd., shale,	
chert	2945
lime, shale	3058
lime, chalk	3105
lime chalky, shale	3262
lime	3439
lime chalky, shale	3537
lime	3770
lime chalky	3870
lime	3965
lime, shale	4108
lime	4120
lime, shale	4237
lime	4272
lime, shale	4338
lime	4378
lime, shale	4534
lime, chalk	4577
lime, shale	4664
chert, lime	4674
lime	4701
lime, shale	4763
lime	4946
lime, shale	5001
lime	5050
lime sdy	5065
lime	5353
lime, shale	5386
lime	5559
lime, chert	5582
lime	5623
lime, shale	5661
lime sdy	5681
lime	5698
lime, shale	5716
shale, sand	5734
lime	RTD 5890
Total Depth	

Figures indicate Bottom of Formations

Morrow	5646
Morrow sand	5701
Miss.	5733

Handwritten:
 5733
 2734

 999

RECEIVED
 STATE CORPORATION COMMISSION
 JAN 30 1974
 CONSERVATION DIVISION
 Wichita, Kansas

Tops:

Scout	
Lansing	4548
Marmaton	5174
Cherokee	5330
Atoka	5484