


STATE OF KANSAS
STATE CORPORATION COMMISSION

Form CP-1

Give All Information Completely
Make Required Affidavit
Mail or Deliver Report to
Conservation Division
State Corporation Commission
P. O. Box 17027
Wichita, Kansas 67217

WELL PLUGGING RECORD

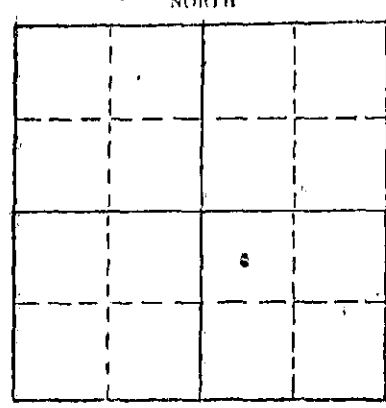

Locate well correctly on above
Section Plat

Meade County, Sec. 3 Twp. 33 Rge. 30 (E) (W) X
Location as "NE/CNW/SE" or footage from lines G NW SE
Lease Owner McAdams Pipe & Supply Co.
Lease Name Leslie Well No. 3
Office Address Drawer 960 Bristow, Oklahoma 74010
Character of Well (completed as Oil, Gas or Dry Hole) Oil
Date well completed March 15 19 56
Application for plugging filed March 11 19 74
Application for plugging approved March 13 19 74
Plugging commenced 4-11 19 74
Plugging completed 4-15 19 74
Reason for abandonment of well or producing formation _____

If a producing well is abandoned, date of last production August 19 69
Was permission obtained from the Conservation Division or its agents before plugging was commenced? Yes

Name of Conservation Agent who supervised plugging of this well Ed Eyes
Producing formation Morrow Depth to top 5664 Bottom 5703 Total Depth of Well 5840 Feet
Show depth and thickness of all water, oil and gas formations.

OIL, GAS OR WATER RECORDS

CASING RECORD

FORMATION	CONTENT	FROM	TO	SIZE	PUT IN	PULLED OUT
				9 5/8	1566	none
				5 1/2	5826	3110

Describe in detail the manner in which the well was plugged, indicating where the mud fluid was placed and the method or methods used in introducing it into the hole. If cement or other plugs were used, state the character of same and depth placed, from _____ feet to _____ feet for each plug set.

Pump 20 sks. of cement to 5500
Pump 35 sks. of cement @ 900 to 800
Put 15 sks. of cement @ 45 to 0

RECEIVED
STATE CORPORATION COMMISSION
MAY 1 - 1974
CONSERVATION DIVISION
Wichita, Kansas

(If additional description is necessary, use BACK of this sheet)
Name of Plugging Contractor Sargents Casing Pulling Service Kansas No. 511
Address Box 506 Liberal, Kansas 67901

STATE OF OKLAHOMA COUNTY OF CREEK ss.
T. P. McAdams, Jr. (employee of owner) or (owner or operator) of the above-described

well, being first duly sworn on oath, says: That I have knowledge of the facts, statements, and matters herein contained and the log of the above-described well as filed and that the same are true and correct. So help me God.

(Signature) [Signature]
P. O. Drawer 960 - Bristow, Oklahoma 74010 (Address)

SUBSCRIBED AND SWORN to before me this 29th day of April 19 74

[Signature]
Notary Public.

WELL LOG BUREAU—KANSAS GEOLOGICAL SOCIETY
508 East Murdock, Wichita, Kansas


Company- COLORADO OIL & GAS
Farm- Leslie No. 3

SEC. 3 T. 33 R. 30W
C NW SE

Total Depth. 5840'
Comm. 11-26-55 Comp. 12-24-55

County Meade
KANSAS

Shot or Treated.
Contractor. Nye & Snell Drlg. Co,
Issued. 6-9-56

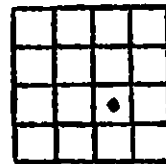

Elevation. 2728 G.L. (L & S)

CASING:

9 5/8" 1585' w/500 sx cem.
5 1/2" 5826' w/200 sx cem.

Production. 1073 bbls.

Figures indicate Bottom of Formations.

sand-shale	140	DST #1 - 5718'
sand-shells	625	DST #2 --5840'
red bed-shells	1040	Open, light blow- Tool open
sand-shell	1245	2 hrs. Shut in 1/2 hr.
no log	1360	Gas - 850-80 slightly gas
shells	1500	cut mud. Rotary mud.
anhydrite	1510	
shale-anhydrite	2055	
shale-shells	2170	
anhydrite-shale	2478	
lime	2545	
lime-shale	2635	
lime	2674	
lime-pyrite	2699	
lime	2730	
lime-shale	2930	
lime	3048	
lime-shale	3090	
lime	3140	
lime-shale	3255	
lime	3325	
lime-shale	3475	
lime	3600	
lime-shale	3999	
lime	4065	
lime-shale	4540	
lime-chert	4607	
lime-shale	4670	
lime-chert	4725	
shale-chert-lime	4825	
lime	4880	
lime-shale	4945	
lime	5010	
lime-shale	5130	
lime	5190	
lime-shale	5395	
lime	5450	
lime-shale	5535	
lime	5580	
lime-shale	5605	
lime	??	
lime-shale	3090	
Morrow sand @ 5654'		
lime-sand	5718	
lime	5770	
lime-shale	5840	
Total Depth		

TOPS:	
Waubensee	3606
Toronto	4356
Lansing	4527
Morrow	5620
Mississippi	5703

Ran Schlumberger

RECEIVED
STATE CORPORATION COMMISSION
MAR 13 1974
CONSERVATION DIVISION
Wichita, Kansas

5703
2138

965