

STATE OF KANSAS
STATE CORPORATION COMMISSION


Form C-11

Give All Information Completely
Make Required Affidavit
Mail or Deliver Report to
Conservation Division
State Corporation Commission
P. O. Box 17027
Wichita, Kansas 67217

WELL PLUGGING RECORD

Meade County, Sec. 3 Twp. 33 Rge. 30 (E) (W) X

Location as "NE/CNWESW" or footage from lines G NE SW
Lease Owner: McAdams Pipe & Supply Co.
Lease Name: Kelly Well No. 1-3
Office Address: Drawer 960 Bristow, Oklahoma 74010
Character of Well (completed as Oil, Gas or Dry Hole) Oil
Date well completed Oct. 14 1955
Application for plugging filed March 11 1974
Application for plugging approved March 13 1974
Plugging commenced 4-20-74 19
Plugging completed 4-25 1974
Reason for abandonment of well or producing formation Depleted

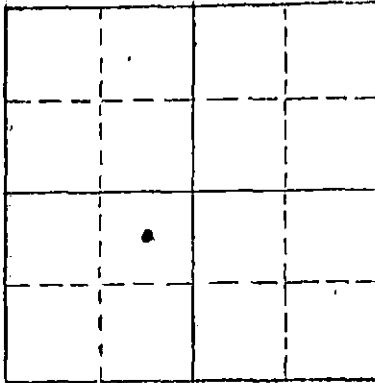

Locate well correctly on above
Section Plat

If a producing well is abandoned, date of last production May 3 1973
Was permission obtained from the Conservation Division or its agents before plugging was commenced? Yes

Name of Conservation Agent who supervised plugging of this well Ed Eyes
Producing formation Morrow Depth to top 5676 Bottom 5688 Total Depth of Well 5812 Feet
Show depth and thickness of all water, oil and gas formations.

OIL, GAS OR WATER RECORDS

CASING RECORD

FORMATION	CONTENT	FROM	TO	SIZE	PUT IN	PULLED OUT
				8 5/8	2675	701
				5 1/2	5811	2851
				13 3/8	651	none

Describe in detail the manner in which the well was plugged, indicating where the mud fluid was placed and the method or methods used in introducing it into the hole. If cement or other plugs were used, state the character of same and depth placed, from _____ feet to _____ feet for each plug set.

Pump 20 sks. of cement to 5550
Pump 50 sks. of cement @ 900 to 800
Put 20 sks. of cement @ 410 to 0

RECEIVED
STATE CORPORATION COMMISSION
MAY 13 1974
CONSERVATION DIVISION
Wichita, Kansas

(If additional description is necessary, use BACK of this sheet)
Name of Plugging Contractor Sargents Casing Pulling Service Kansas No. 511
Address Box 506 Liberal, Kansas 67901

STATE OF OKLAHOMA COUNTY OF CREEK ss.
T. P. McADAMS, JR.

(employee or owner) or (owner or operator) of the above-described well, being first duly sworn on oath, says: That I have knowledge of the facts, statements, and matters herein contained and the log of the above-described well as filed and that the same are true and correct. So help me God.

(Signature)

P. O. Drawer 960 - Bristow, Okla. 74010
(Address)

Subscribed and sworn to before me this 10th day of May 1974

My commission expires September 23, 1974

Notary Public.

WELL LOG BUREAU—KANSAS GEOLOGICAL SOCIETY
508 East Murdock, Wichita, Kansas

COPY


Company. COLORADO OIL & GAS CORPORATION
Farm- Kelly No. 1

SEC. 3 T. 33 R. 30W
C NE SW

Total Depth. 5842
Comm. 9-7-55
Shot or Treated.
Contractor.
Issued. 12-17-55

Comp. 11-18-55

County Meade
KANSAS

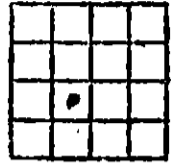

Elevation. 2737 RB

Production. 1722 BOPD

CASING:
13 3/8 651'
8 5/8 2675'
5 1/2 5811'

Figures indicate Bottom of Formations.

sand & shells	670
red bed	1020
sand, red bed & shells	1755
shale & shells	2015
red bed, shale & lime	2226
shale, shells & lime	2377
lime & shale	2485
lime, shale, anhydrite & chert	2582
lime & shale	2635
lime & chert	2685
reaming	2680
lime	2806
lime & shale	3687
lime	4230
lime, chert & shale	4415
lime & shale	4586
lime	4887
lime & shale	4991
lime	5130
lime & shale	5200
lime	5265
lime & shale	5300
lime	5304
lime & shale	5375
lime	5450
lime & shale	5515
lime	5540
lime & shale	5630
lime	5661
Morrow sand	5718
lime & shale	5770
lime	5842
Total Depth	

SCOUT TOPS:	
Herington	2674
Lansing	4510
Morrow shale	5623
Morrow sand	5664
Mississippi	5703

RECEIVED
STATE CORPORATION COMMISSION
MAR 13 1974
CONSERVATION DIVISION
Wichita, Kansas

5703
2737

2966