

This form shall be filed in duplicate with the Kansas Corporation Commission, 200 Colorado Derby Building, Wichita, Kansas 67202, within ten days after the completion of the well, regardless of how the well was completed.

Attach separate letter of request if the information is to be held confidential. If confidential, only file one copy. Information on side one will be of public record and side two will then be held confidential.

Circle one: Oil, Gas, Dry, SWD, OWWO, Injection. Type and complete ALL sections. Gas Storage Applications must be filed for dual completion, commingling, SWD and injection.

Attach wireline logs (i.e. electrical log, sonic log, gamma ray neutron log, etc.). KCC # (316) 263-3238. (Rules 82-2-105 & 82-2-125)

OPERATOR Southwest Gas Storage Company

API NO. 15 119 20520-00-00

ADDRESS P. O. Box 1348

COUNTY Meade

Kansas City, Missouri 64141

FIELD Borchers North

**CONTACT PERSON D. R. Carlile

PROD. FORMATION Morrow

PHONE (316) 873-5469

LEASE Heydecker

PURCHASER Panhandle Eastern Pipe Line Company

WELL NO. 3-34

ADDRESS P.O. Box 1348

WELL LOCATION 2400'S & 2400'W from

Kansas City, Missouri 64141

Ft. from Line and

DRILLING Sage Drilling Company, Inc.

Ft. from Line of

CONTRACTOR

ADDRESS 222 Sutton Place

the NE/4 SEC. 34 TWP. 32S RGE. 28W


Wichita, Kansas 67202

WELL PLAT

PLUGGING

CONTRACTOR

ADDRESS

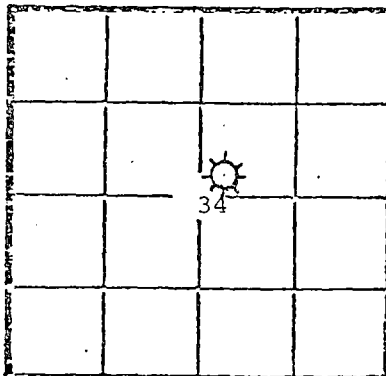

KCC
KGS
(Office Use)

RECEIVED
STATE CORPORATION COMMISSION
JUN - 9 1982
6-a-82
CONSERVATION DIVISION
Wichita, Kansas

TOTAL DEPTH 5727' PBTD 5685'

SPUD DATE 9-17-81 DATE COMPLETED 10-23-81

ELEV: GR 2475' DF - KB -

DRILLED WITH (CABLE) (ROTARY) (AIR) TOOLS

Amount of surface pipe set and cemented 2594' DV Tool Used?

A F F I D A V I T

STATE OF KANSAS, COUNTY OF MEADE SS, I,

D. R. CARLILE OF LAWFUL AGE, BEING FIRST DULY SWORN UPON HIS OATH,

DEPOSES THAT HE IS FIELD SUPERINTENDENT (FOR)(OF) SOUTHWEST GAS STORAGE COMPANY

OPERATOR OF THE BORCHERS NORTH GAS STG. FIELD LEASE, AND IS DULY AUTHORIZED TO MAKE

THIS AFFIDAVIT FOR AND ON THE BEHALF OF SAID OPERATOR, THAT WELL NO. 3-34 ON

SAID LEASE HAS BEEN COMPLETED AS OF THE 23rd DAY OF OCTOBER, 1981, AND THAT

ALL INFORMATION ENTERED HEREIN WITH RESPECT TO SAID WELL IS TRUE AND CORRECT.

FURTHER AFFIANT SAITH NOT.

(s) [Signature]

SUBSCRIBED AND SWORN BEFORE ME THIS 23rd DAY OF April, 1982

Appt. MY COMMISSION EXPIRES: June 16, 1982

[Signature] NOTARY PUBLIC Wilma Pennington

**The person who can be reached by phone regarding any questions concerning this information. Within 45 days of completion, a witnessed initial test by the Commission is required if the well produces more than 25 FOPD or is located in a Basic Order Pool.