

This form shall be filed in duplicate with the Kansas Corporation Commission, 200 Colorado Derby Building, Wichita, Kansas 67202, within ten days after the completion of the well, regardless of how the well was completed.

Attach separate letter of request if the information is to be held confidential. If confidential, only file one copy. Information on side one will be of public record and side two will then be held confidential.

Circle one: Oil, Gas, Dry, SWD, OWWO, Injection. Type and complete ALL sections. Gas Storage
Applications must be filed for dual completion, commingling, SWD and injection.

Attach wireline logs (i.e. electrical log, sonic log, gamma ray neutron log, etc.).
KCC # (316) 263-3238. (Rules 82-2-105 & 82-2-125)

OPERATOR Southwest Gas Storage Company

API NO. 15 119 20444-00-00

ADDRESS Box 1348

COUNTY Meade

Kansas City, Missouri 64141

FIELD Borchers North

**CONTACT PERSON Mr. D. R. Carlile

PROD. FORMATION Morrow

PHONE (316) 873-5469

LEASE Heydecker

PURCHASER Panhandle Eastern Pipe Line Company

WELL NO. 2-34

ADDRESS Box 1348

WELL LOCATION 145'N & 150'W from

Kansas City, Missouri 64141

Ft. from Line and

DRILLING Sage Drilling Company, Inc.

Ft. from Line of

CONTRACTOR


ADDRESS 222 Sutton Place

SE/c

Wichita, Kansas 67202

the NE 1/4 SEC. 34 TWP. 32S RGE. 28W

WELL PLAT

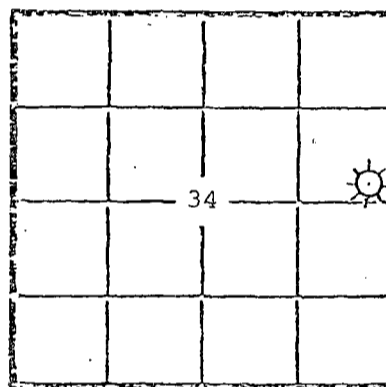

KCC
KGS
(Office Use)

SE/c of NE 1/4

TOTAL DEPTH 5750 PBD 5713

SPUD DATE 12-5-80 DATE COMPLETED 7-7-81

ELEV: GR 2493' DF KB 2504'

DRILLED WITH (CABLE) (ROTARY) (AIR) TOOLS

Amount of surface pipe set and cemented 2581' DV Tool Used? No

AFFIDAVIT

STATE OF KANSAS, COUNTY OF MEADE SS, I,

D. R. CARLILE OF LAWFUL AGE, BEING FIRST DULY SWORN UPON HIS OATH,

DEPOSES THAT HE IS FIELD SUPERINTENDENT (FOR)(OF) SOUTHWEST GAS STORAGE COMPANY

OPERATOR OF THE BORCHERS NORTH GAS STG. FIELD LEASE, AND IS DULY AUTHORIZED TO MAKE

THIS AFFIDAVIT FOR AND ON THE BEHALF OF SAID OPERATOR, THAT WELL NO. 2-34 ON

SAID LEASE HAS BEEN COMPLETED AS OF THE 7th DAY OF JULY, 19 81, AND THAT

ALL INFORMATION ENTERED HEREIN WITH RESPECT TO SAID WELL IS TRUE AND CORRECT.

FURTHER AFFIANT SAITH NOT.

(s) [Signature]

SUBSCRIBED AND SWORN BEFORE ME THIS 23rd DAY OF April, 19 82.

appt.

MY COMMISSION EXPIRES: June 16, 1982

[Signature]
NOTARY PUBLIC
Wilma Pennington

**The person who executed this affidavit shall be held liable for any false information regarding any questions concerning this information. Within 45 days after the completion of this well, a witnessed initial test by the Commission is required if the well is not a POB or is located in a Basic Order Pool.

RECEIVED
STATE CORPORATION COMMISSION
CONSERVATION DIVISION
Wichita, Kansas
JUN - 9 1982
Co-9-82