DISTRICT CONSERVATION AGENT'S REPORT

County

Eavy wlany

Dry Hole Abandoned Oil Well Abandoned Gas Well

I have this date completed supervision of plugging of:

Well No. / Lease & & Leslis


Plugging Contractor Midu Filen

TO:

Field

State Corporation Commission Conservation Division 800 Bitting Building Wichita, Kansas

Total Depth 6/35 Feet.

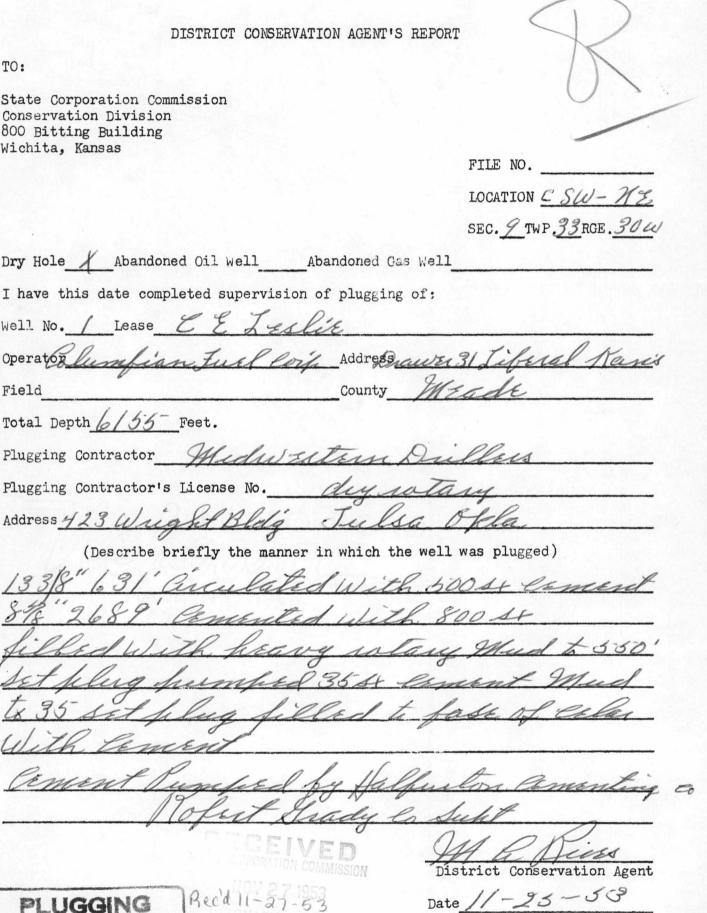

Recd 11-27-5 AVATION DIVISION Tohita, Kansas

Date //-23-53