

STATE CORPORATION COMMISSION OF KANSAS
OIL & GAS CONSERVATION DIVISION
RECOMPLETION FORM
ACO-2 AMENDMENT TO WELL HISTORY

API NO. 15- 129-20,868-00-00
County Morton
C NE/4 Sec 19 Twp 33S Rge 39 X East
X West
3960 Ft North from Southeast Corner of Section
1320 Ft West from Southeast Corner of Section
(Note: Locate well in section plat below)

Operator: License # 5598
Name APX Corporation
Address P. O. Box 351
City/State/Zip Liberal, Kansas 67905-0351

Lease Name Moeschl "A" Well # 2H
Field Name Hugoton
Name of New Formation Chase
Elevation: Ground 3251.6 KB NA

Purchaser Panhandle Eastern Pipe Line Co.
(Transporter)
Operator Contact Person M. L Pease
Phone (316) 624-6253

Designate Type of Original Completion
 New Well Re-Entry Workover
 Oil SWD Temp Abd
 Gas Inj Delayed Comp.
 Dry Other (Core, Water Supply etc.)

Date of Original Completion: 10-25-88

DATE OF RECOMPLETION:


Commenced _____ Completed _____

Designate Type of Recompletion/Workover:

Deepening Delayed Completion
 Plug Back Re-perforation
 Conversion to Injection/Disposal

Is recompleted production:

Commingled; Docket No. _____
 Dual Completion; Docket No. _____
 Other (Disposal or Injection)? _____

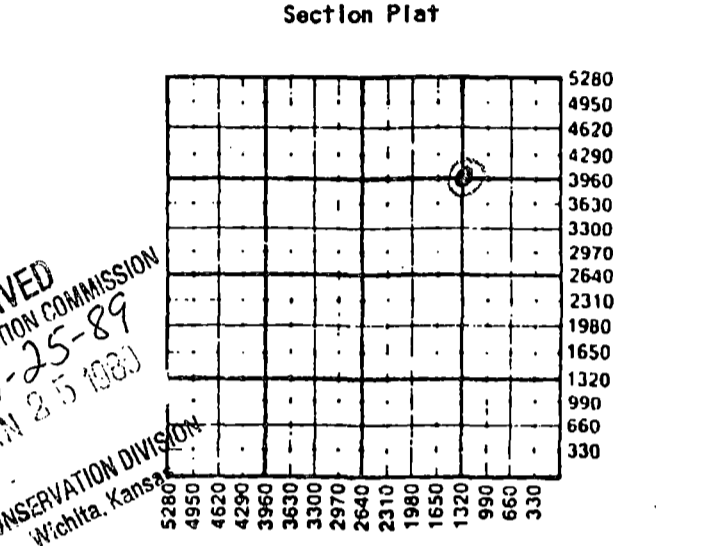

RECEIVED
STATE CORPORATION COMMISSION
1-25-89
JAN 25 1989
CONSERVATION DIVISION
Wichita, Kansas

K.C.C. OFFICE USE ONLY

Letter of Confidentiality Attached
 Wireline Log Received
 Drillers Timelog Received

Distribution

KCC SWD/Rep NGPA
 KGS Plug Other
(Specify)

.....
.....
.....

1-25-89

INSTRUCTIONS: This form shall be completed in triplicate and filed with the Kansas Corporation Commission, 200 Colorado Derby Building, Wichita, Kansas 67202, within 120 days of the recompletion of any well. Rules 82-3-107 and 82-3-141 apply. Information on side two of this form will be held confidential for a period of 12 months if requested in writing and submitted with the form. See rule 82-3-107 for confidentiality in excess of 12 months. One copy of any additional wireline logs and driller's time logs (not previously submitted) shall be attached with this form. Submit ACO-4 prior to or with this form for approval of commingling or dual completions. Submit CP-4 with all plugged wells. Submit CP-111 with all temporarily abandoned wells. NOTE: Conversion of wells to either disposal or injection must receive approval before use; submit form U-1.

All requirements of the statutes, rules and regulations promulgated to regulate the oil and gas industry have been fully complied with and the statements herein are complete and correct to the best of my knowledge.

Signature M. L. Pease Title Division Production Mgr. Date 1/23/89

Subscribed and sworn to before me this 24th day of January 19 89

Notary Public William S. Salley Date Commission Expires _____

WILLIAM S. SALLEY
NOTARY PUBLIC
STATE OF KANSAS
FORM ACO-2
5/88