

plugged 11-6-87

STATE CORPORATION COMMISSION OF KANSAS
OIL & GAS CONSERVATION DIVISION
WELL COMPLETION OR RECOMPLETION FORM
ACO-1 WELL HISTORY
DESCRIPTION OF WELL AND LEASE

Operator: License # 5363
Name BEREXCO INC.
Address 970 Fourth Financial Center
Wichita, Kansas 67202
City/State/Zip

Purchaser

Operator Contact Person Evan Mayhew
Phone 316/265-3311

Contractor: License # 5147
Name BEREDCO INC.

Wellsite Geologist
Phone

Designate Type of Completion
New Well Re-Entry Workover
Oil SWD Temp Abd
Gas Inj Delayed Comp.
X Dry Other (Core, Water Supply etc.)

If OWWO: old well info as follows:
Operator
Well Name
Comp. Date Old Total Depth

WELL HISTORY

Drilling Method:
X Mud Rotary Air Rotary Cable
10/10/87 11/5/87 11-6-87
Spud Date Date Reached TD Completion Date
6300'
Total Depth PBSD

Amount of Surface Pipe Set and Cemented at 1611 feet
Multiple Stage Cementing Collar Used? Yes No
If yes, show depth set feet
If alternate 2 completion, cement circulated from feet depth to w/SX cmt
Cement Company Name
Invoice #

API NO. 15-175,20,974-0000
County Seward
SE NE NE Sec 33 Twp 33S Rge 31W East West

4290 Ft North from Southeast Corner of Section
330 Ft West from Southeast Corner of Section
(Note: Locate well in section plat below)


Lease Name Handy Well # 1

Field Name

Producing Formation St. Louis

Elevation: Ground 3707 KB 2720

Section Plat

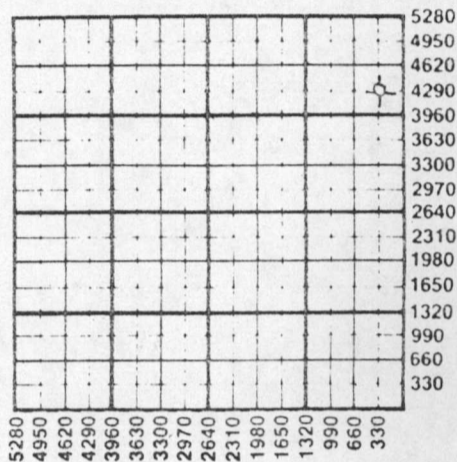

WATER SUPPLY INFORMATION

Disposition of Produced Water: Disposal
Docket # Repressuring

Questions on this portion of the ACO-1 call:

Water Resources Board (913) 296-3717

Source of Water:
Division of Water Resources Permit #

SE NE NE
X Groundwater Ft North from Southeast Corner
(Well) Ft West from Southeast Corner of
Sec 33 Twp 33S Rge 31W East West

Surface Water Ft North from Southeast Corner
(Stream, pond etc) Ft West from Southeast Corner
Sec Twp Rge East West


Other (explain)
(purchased from city, R.W.D. #)

INSTRUCTIONS: This form shall be completed in duplicate and filed with the Kansas Corporation Commission, 200 Colorado Derby Building, Wichita, Kansas 67202, within 90 days after completion or recompletion of any well. Rule 82-3-130 and 82-3-107 apply.

Information on side two of this form will be held confidential for a period of 12 months if requested in writing and submitted with the form. See rule 82-3-107 for confidentiality in excess of 12 months. One copy of all wireline logs and drillers time log shall be attached with this form. Submit CP-4 form with all plugged wells. Submit CP-111 form with all temporarily abandoned wells.

All requirements of the statutes, rules and regulations promulgated to regulate the oil and gas industry have been fully complied with and the statements herein are complete and correct to the best of my knowledge.

Signature Evan C. Mayhew
Title Engineer Date 12-4-87

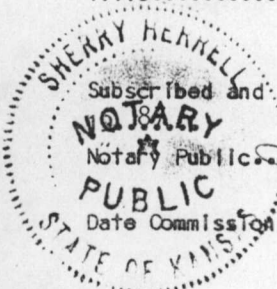

Subscribed and sworn to before me this 4 day of December
Notary Public
Date Commission Expires 3-20-90

K.C.C. OFFICE USE ONLY
Letter of Confidentiality Attached
Wireline Log Received
Drillers Timelog Received
Distribution
KCC SWD/Rep NGPA
KGS Plug Other
(Specify)

Sec 33 Twp 33S Rge 31W